


RECORD PLAN
R 674
 DATE
 15/11/37

A1-29

4 W.P. - 117-aa

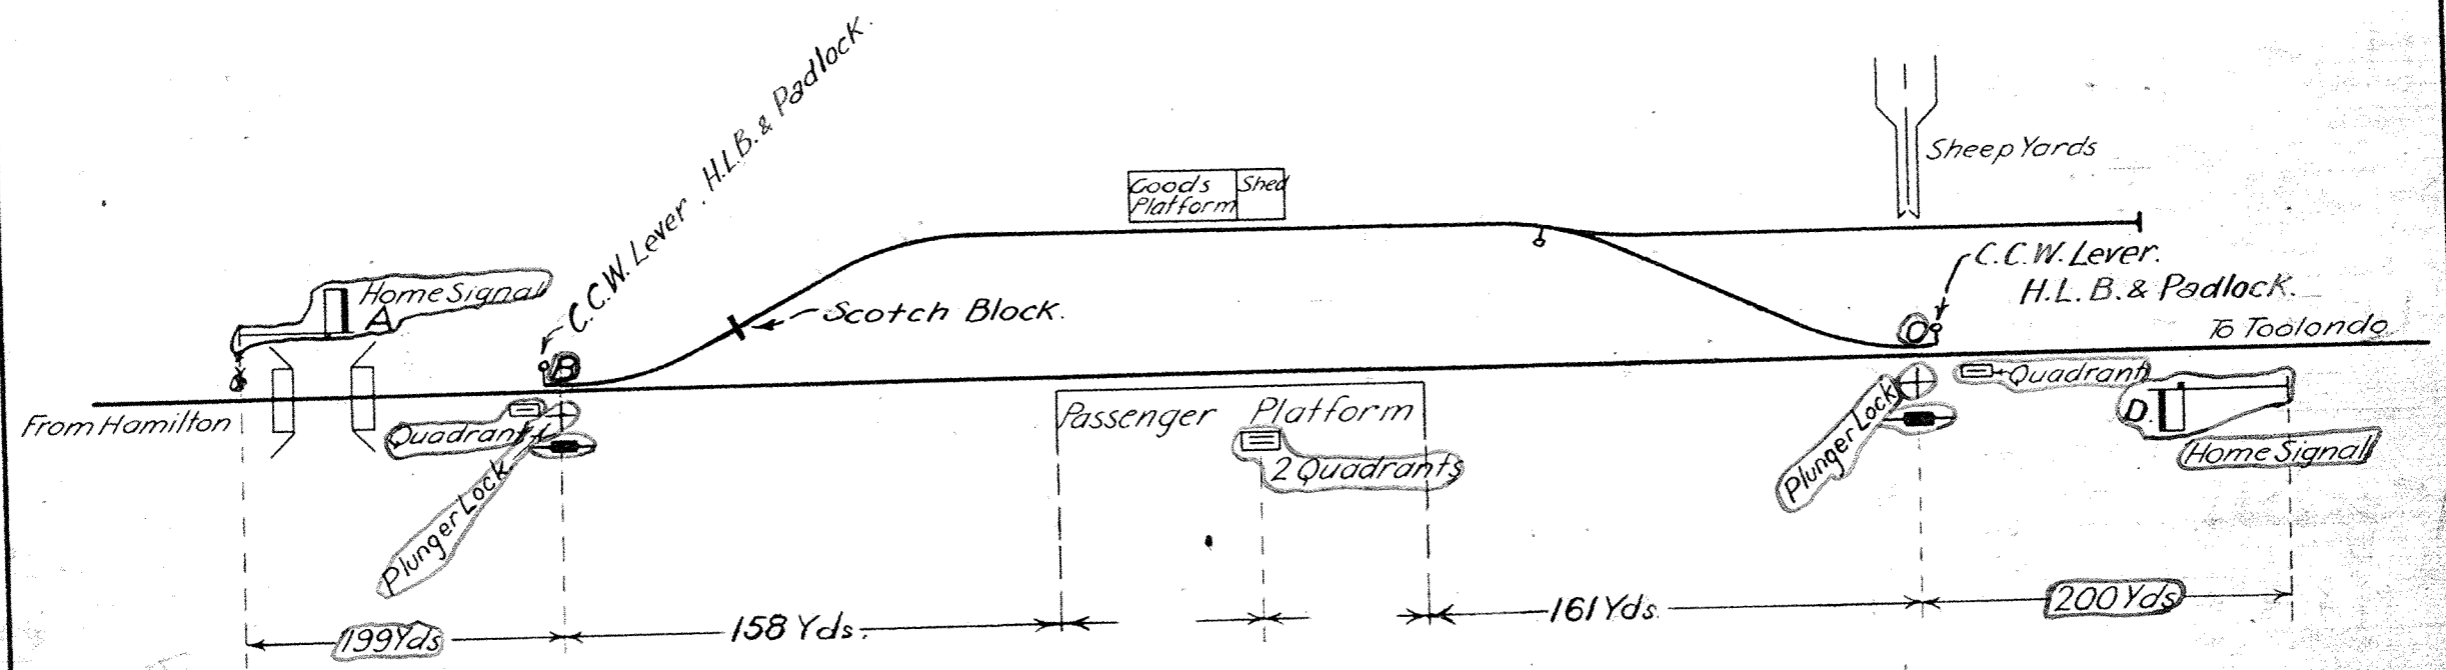

Signal	Mechanically Detects
A	Points "B" Normal and Plunger In when worked from platform.
D	Points "C" Normal and Plunger In when worked from platform.

Points	Detector.
B	
C	

Post	Height	Type
Down Home "A"		
Up Home "D"		

9055/65 W.W.
 133/65 S.T.

In Service 24.5.34	29.6.34	Redrawn as	VR. VASEY	Sig & Tel Engineer	Drawn by G.M.B.	Traced by G.M.B.	F923
Staff Locks, Connections & Derails removed.		in Service					
		dated 6-8-20	Diagram	17-8-33			