


VICTORIAN RAILWAYS, BURRUMBEET PARK RAILWAY

SCALE 4 CHAINS TO AN INCH

RECORD COPY
(PLAN ROOM)

Parish of Burrumbeet

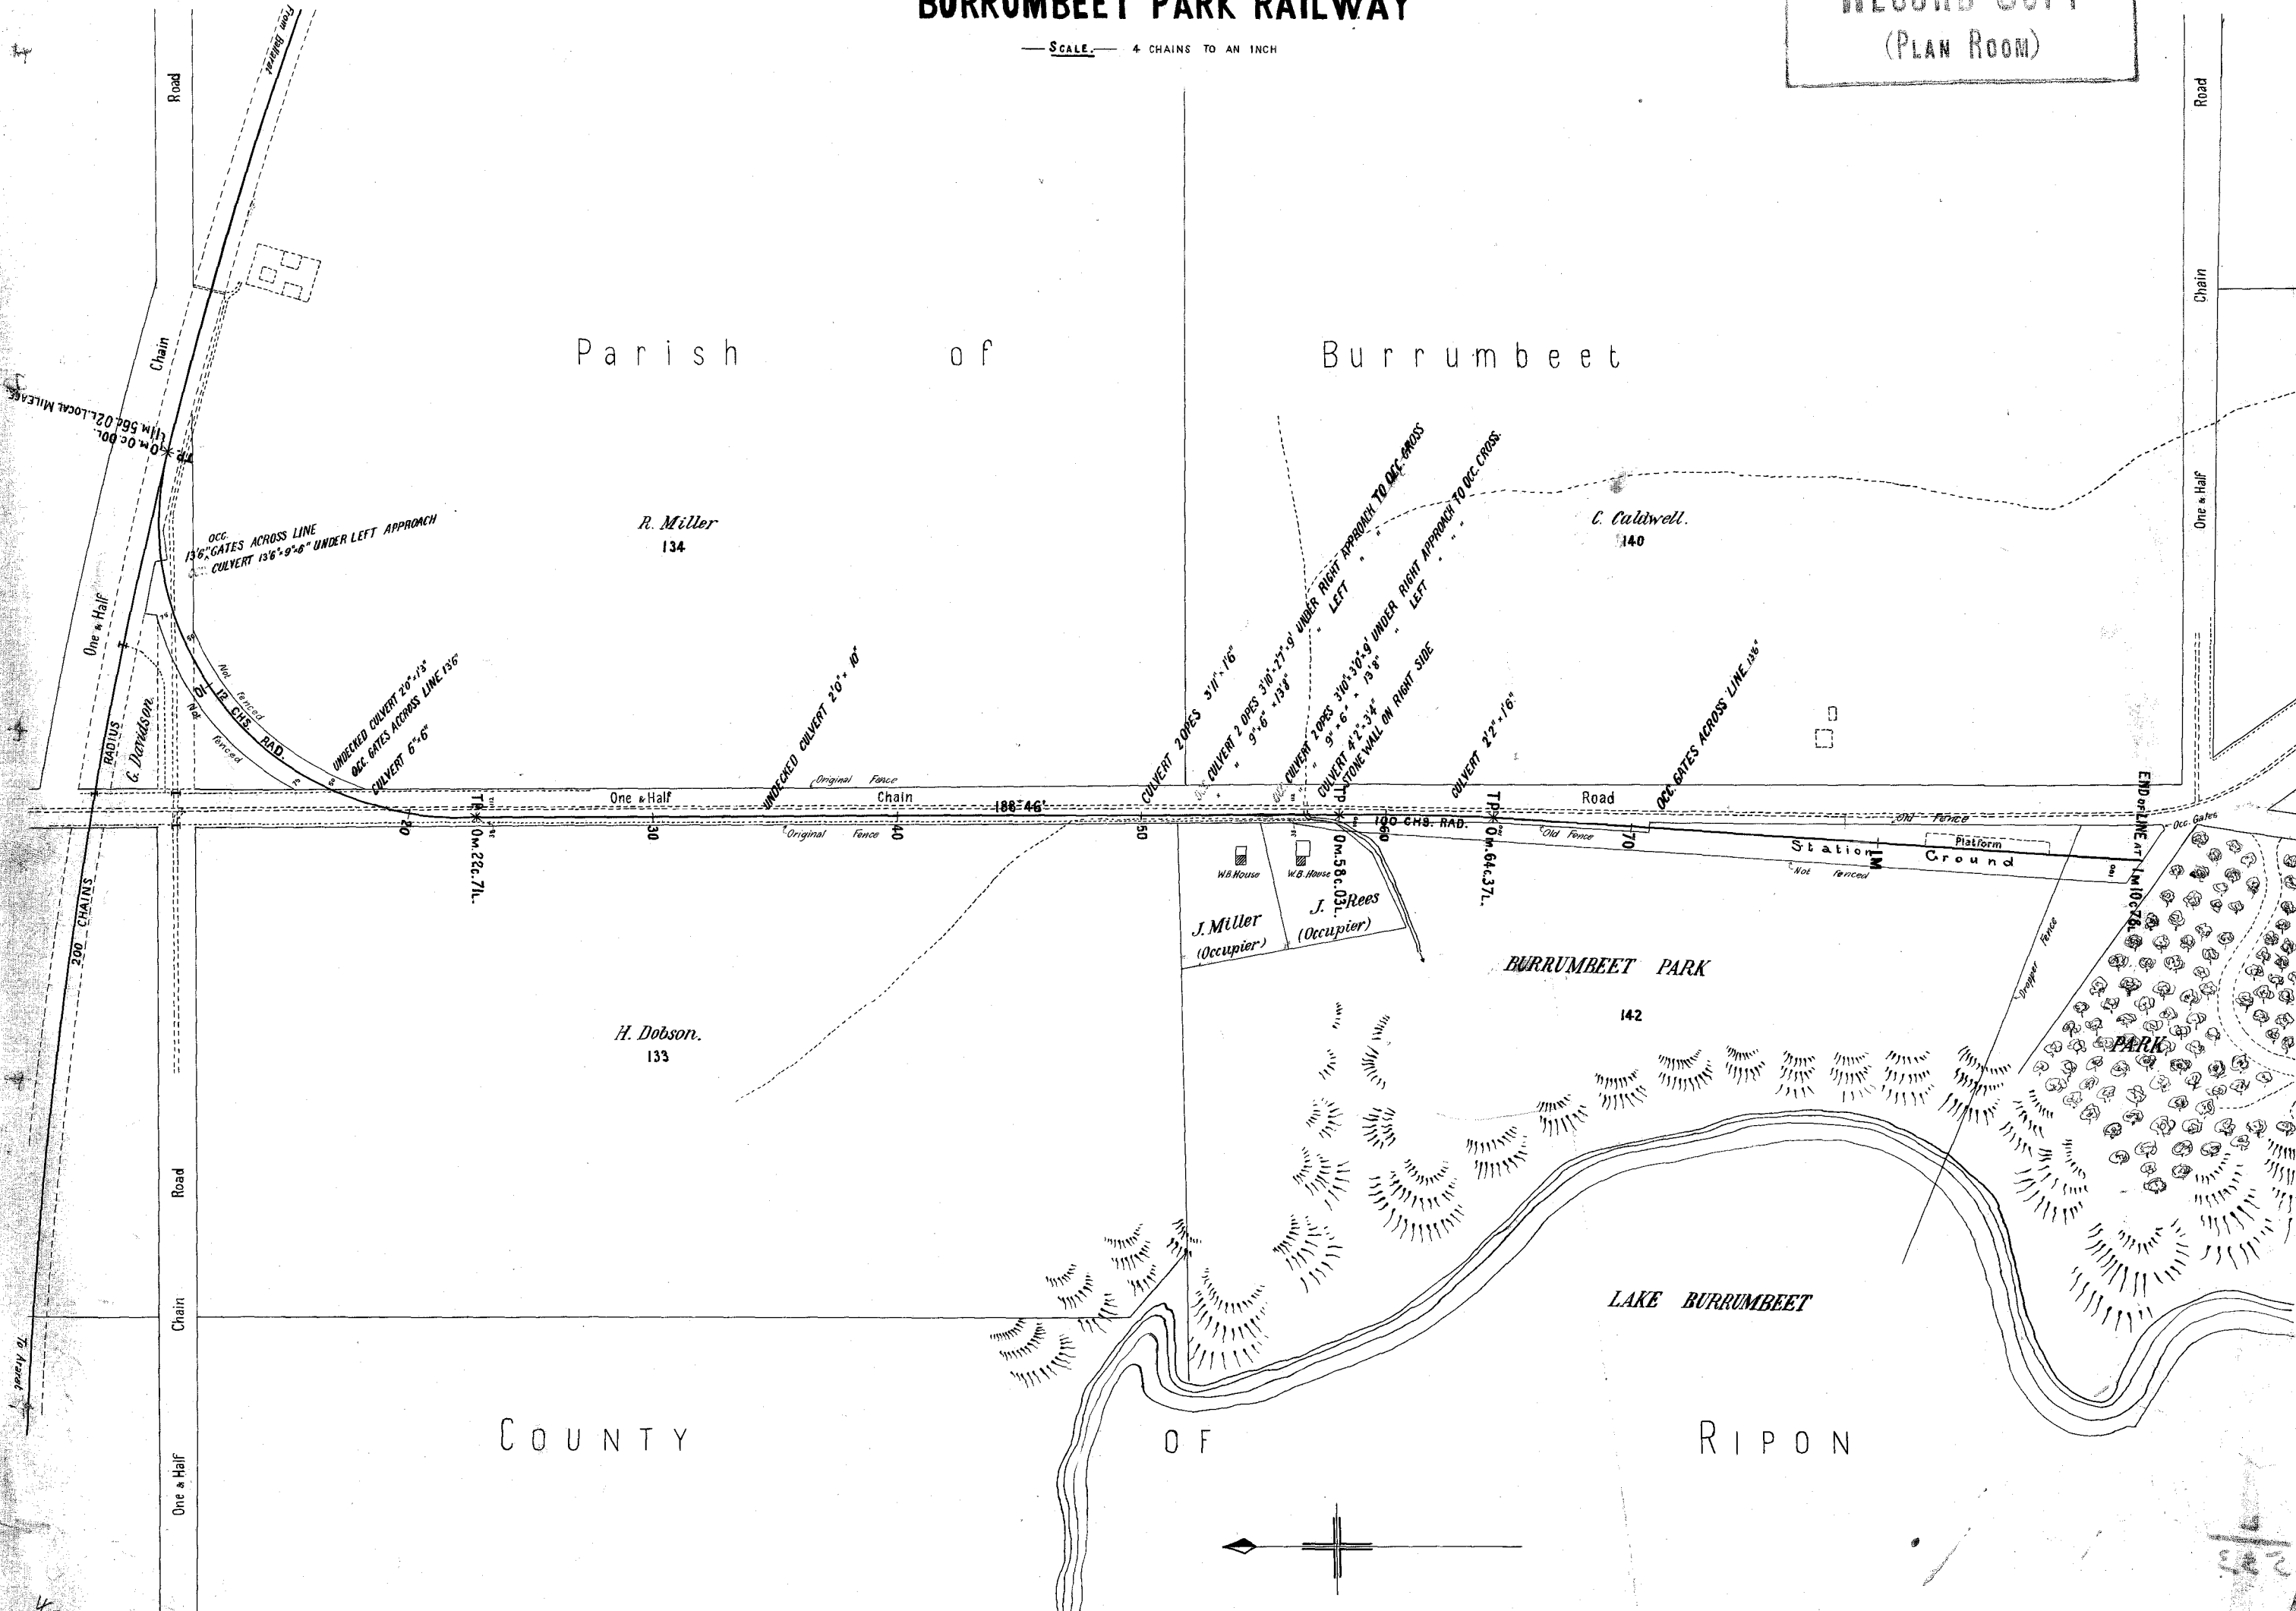

4/62
81

1066.10