


VICTORIAN RAILWAYS, NORADJUHA TO TOOLONDO

SCALE 10 CHAINS TO AN INCH

Nº1

RECORD COPY
(PLAN ROOM)


RECORD COPY
(PLAN ROOM)

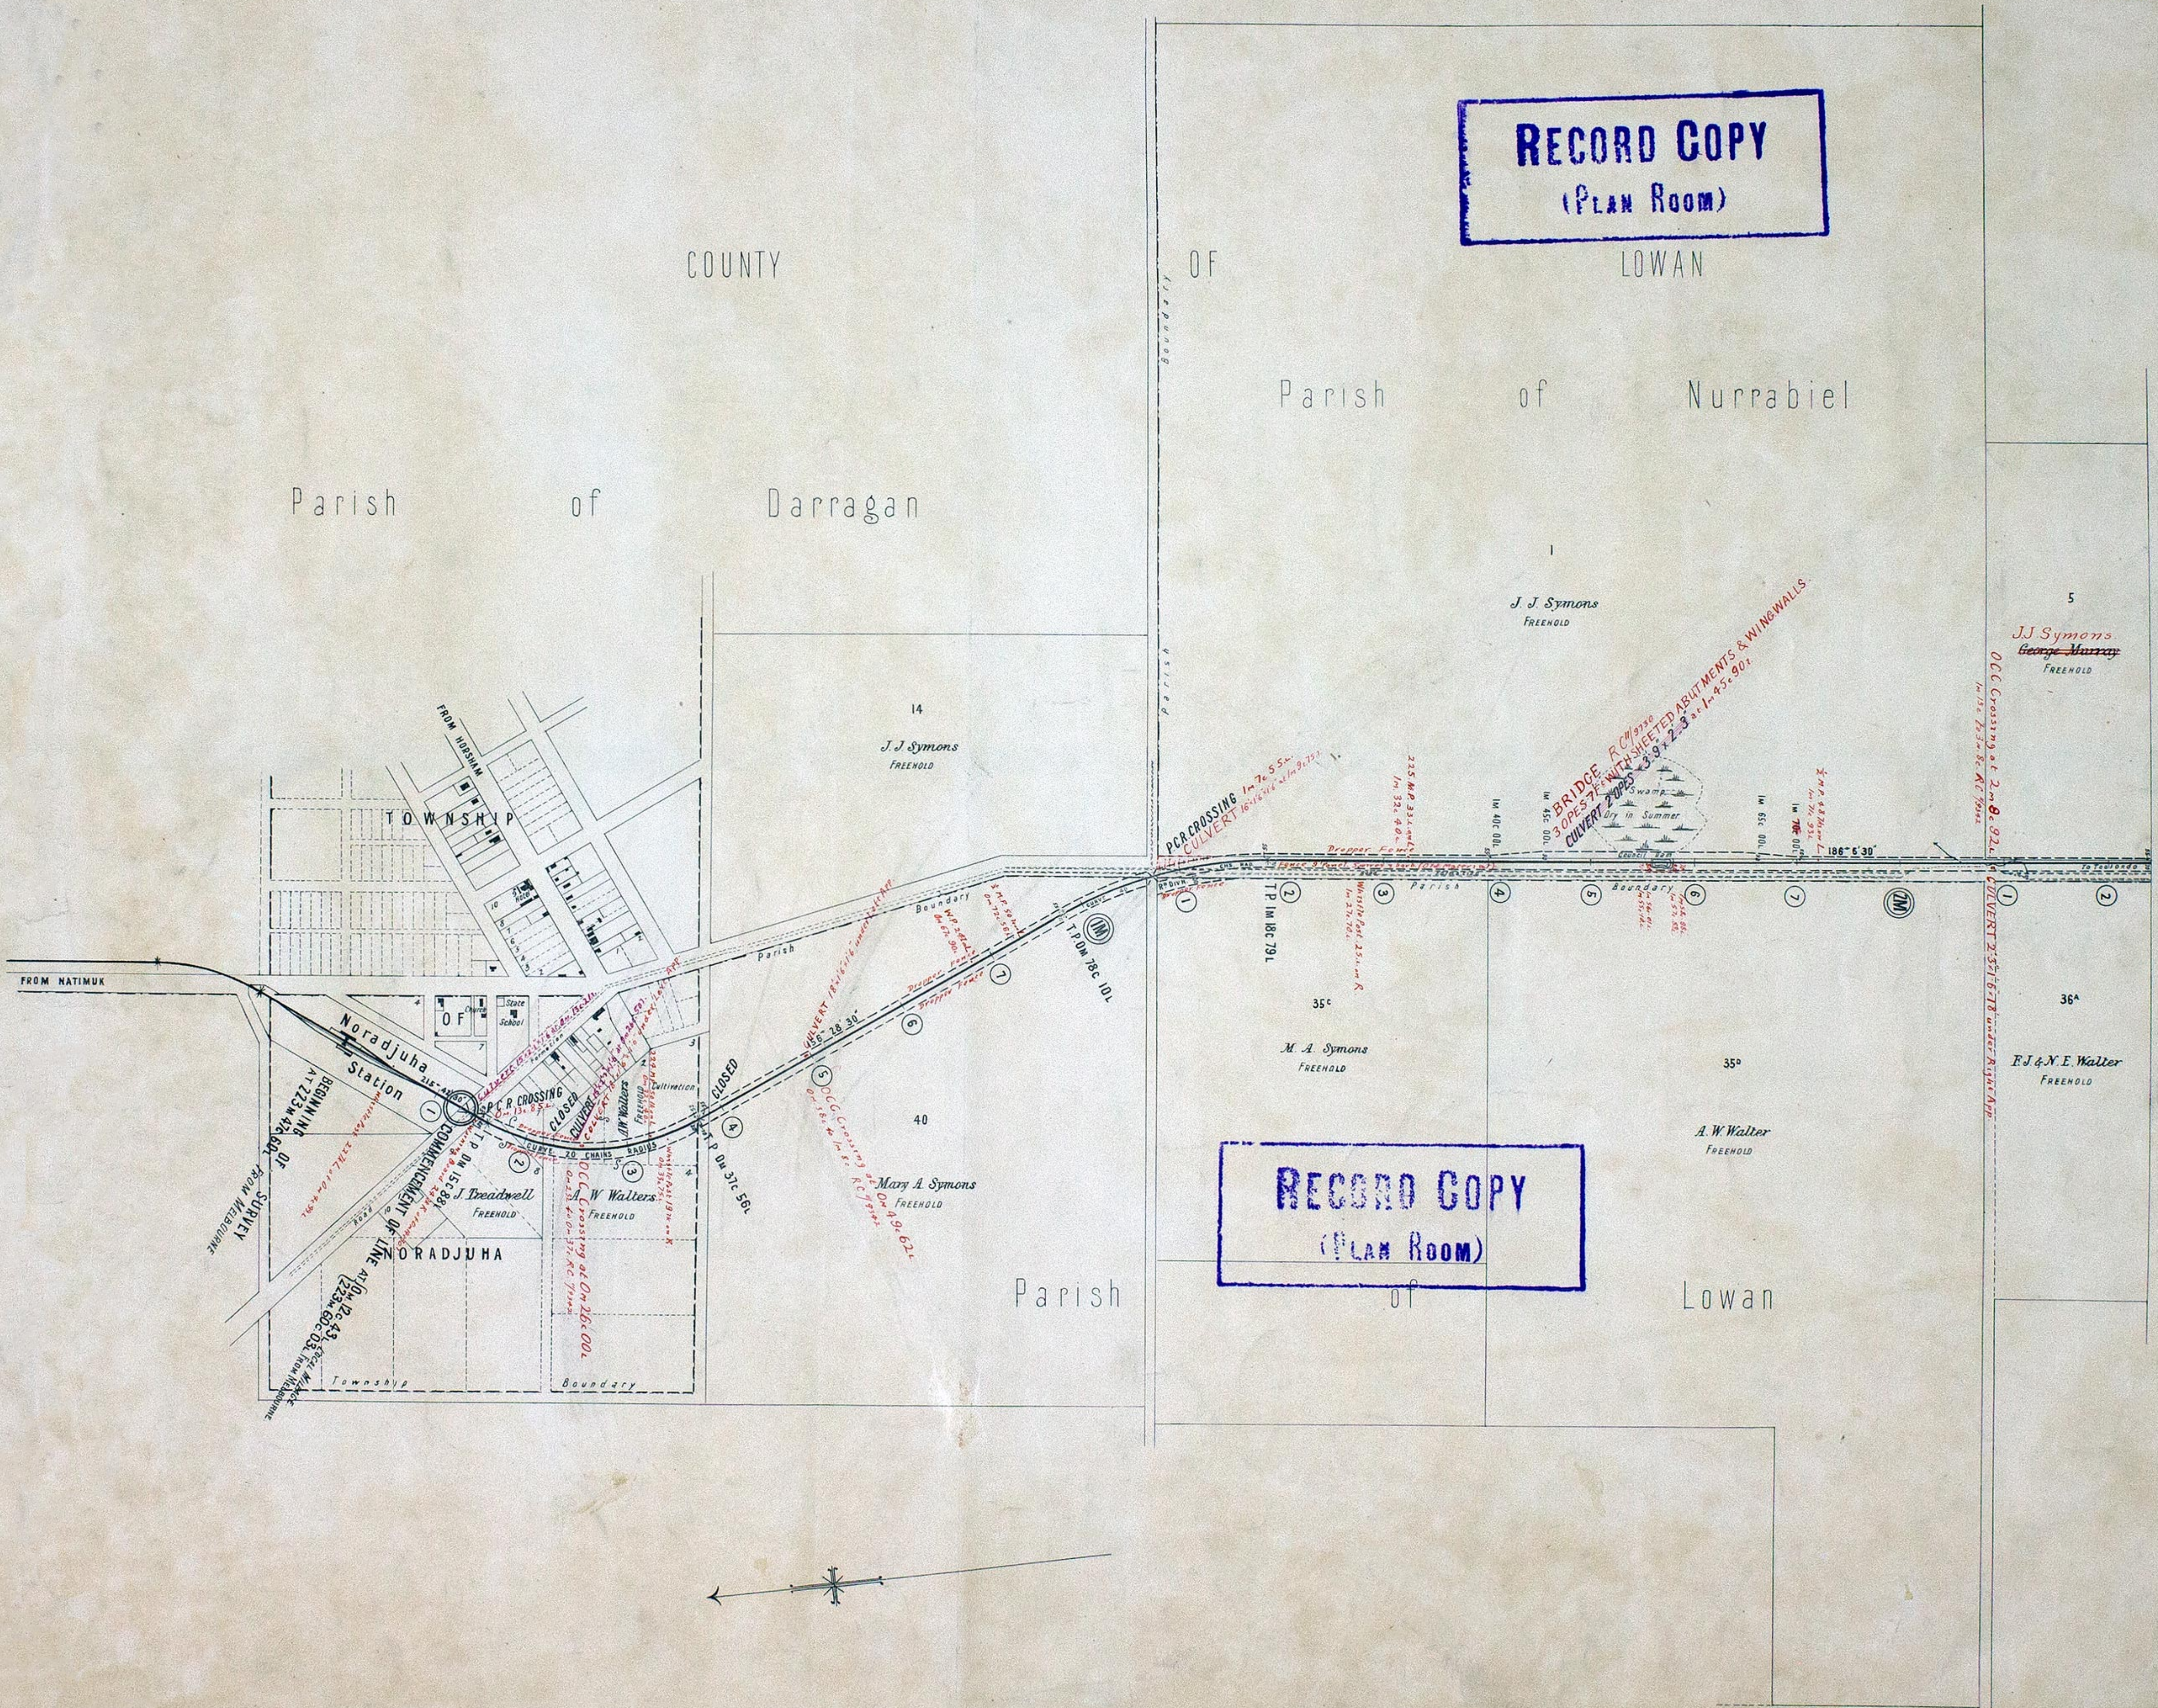

VICTORIAN RAILWAYS, NORADJUHA TO TOOLONDO

SCALE 10 CHAINS TO AN INCH


Nº2

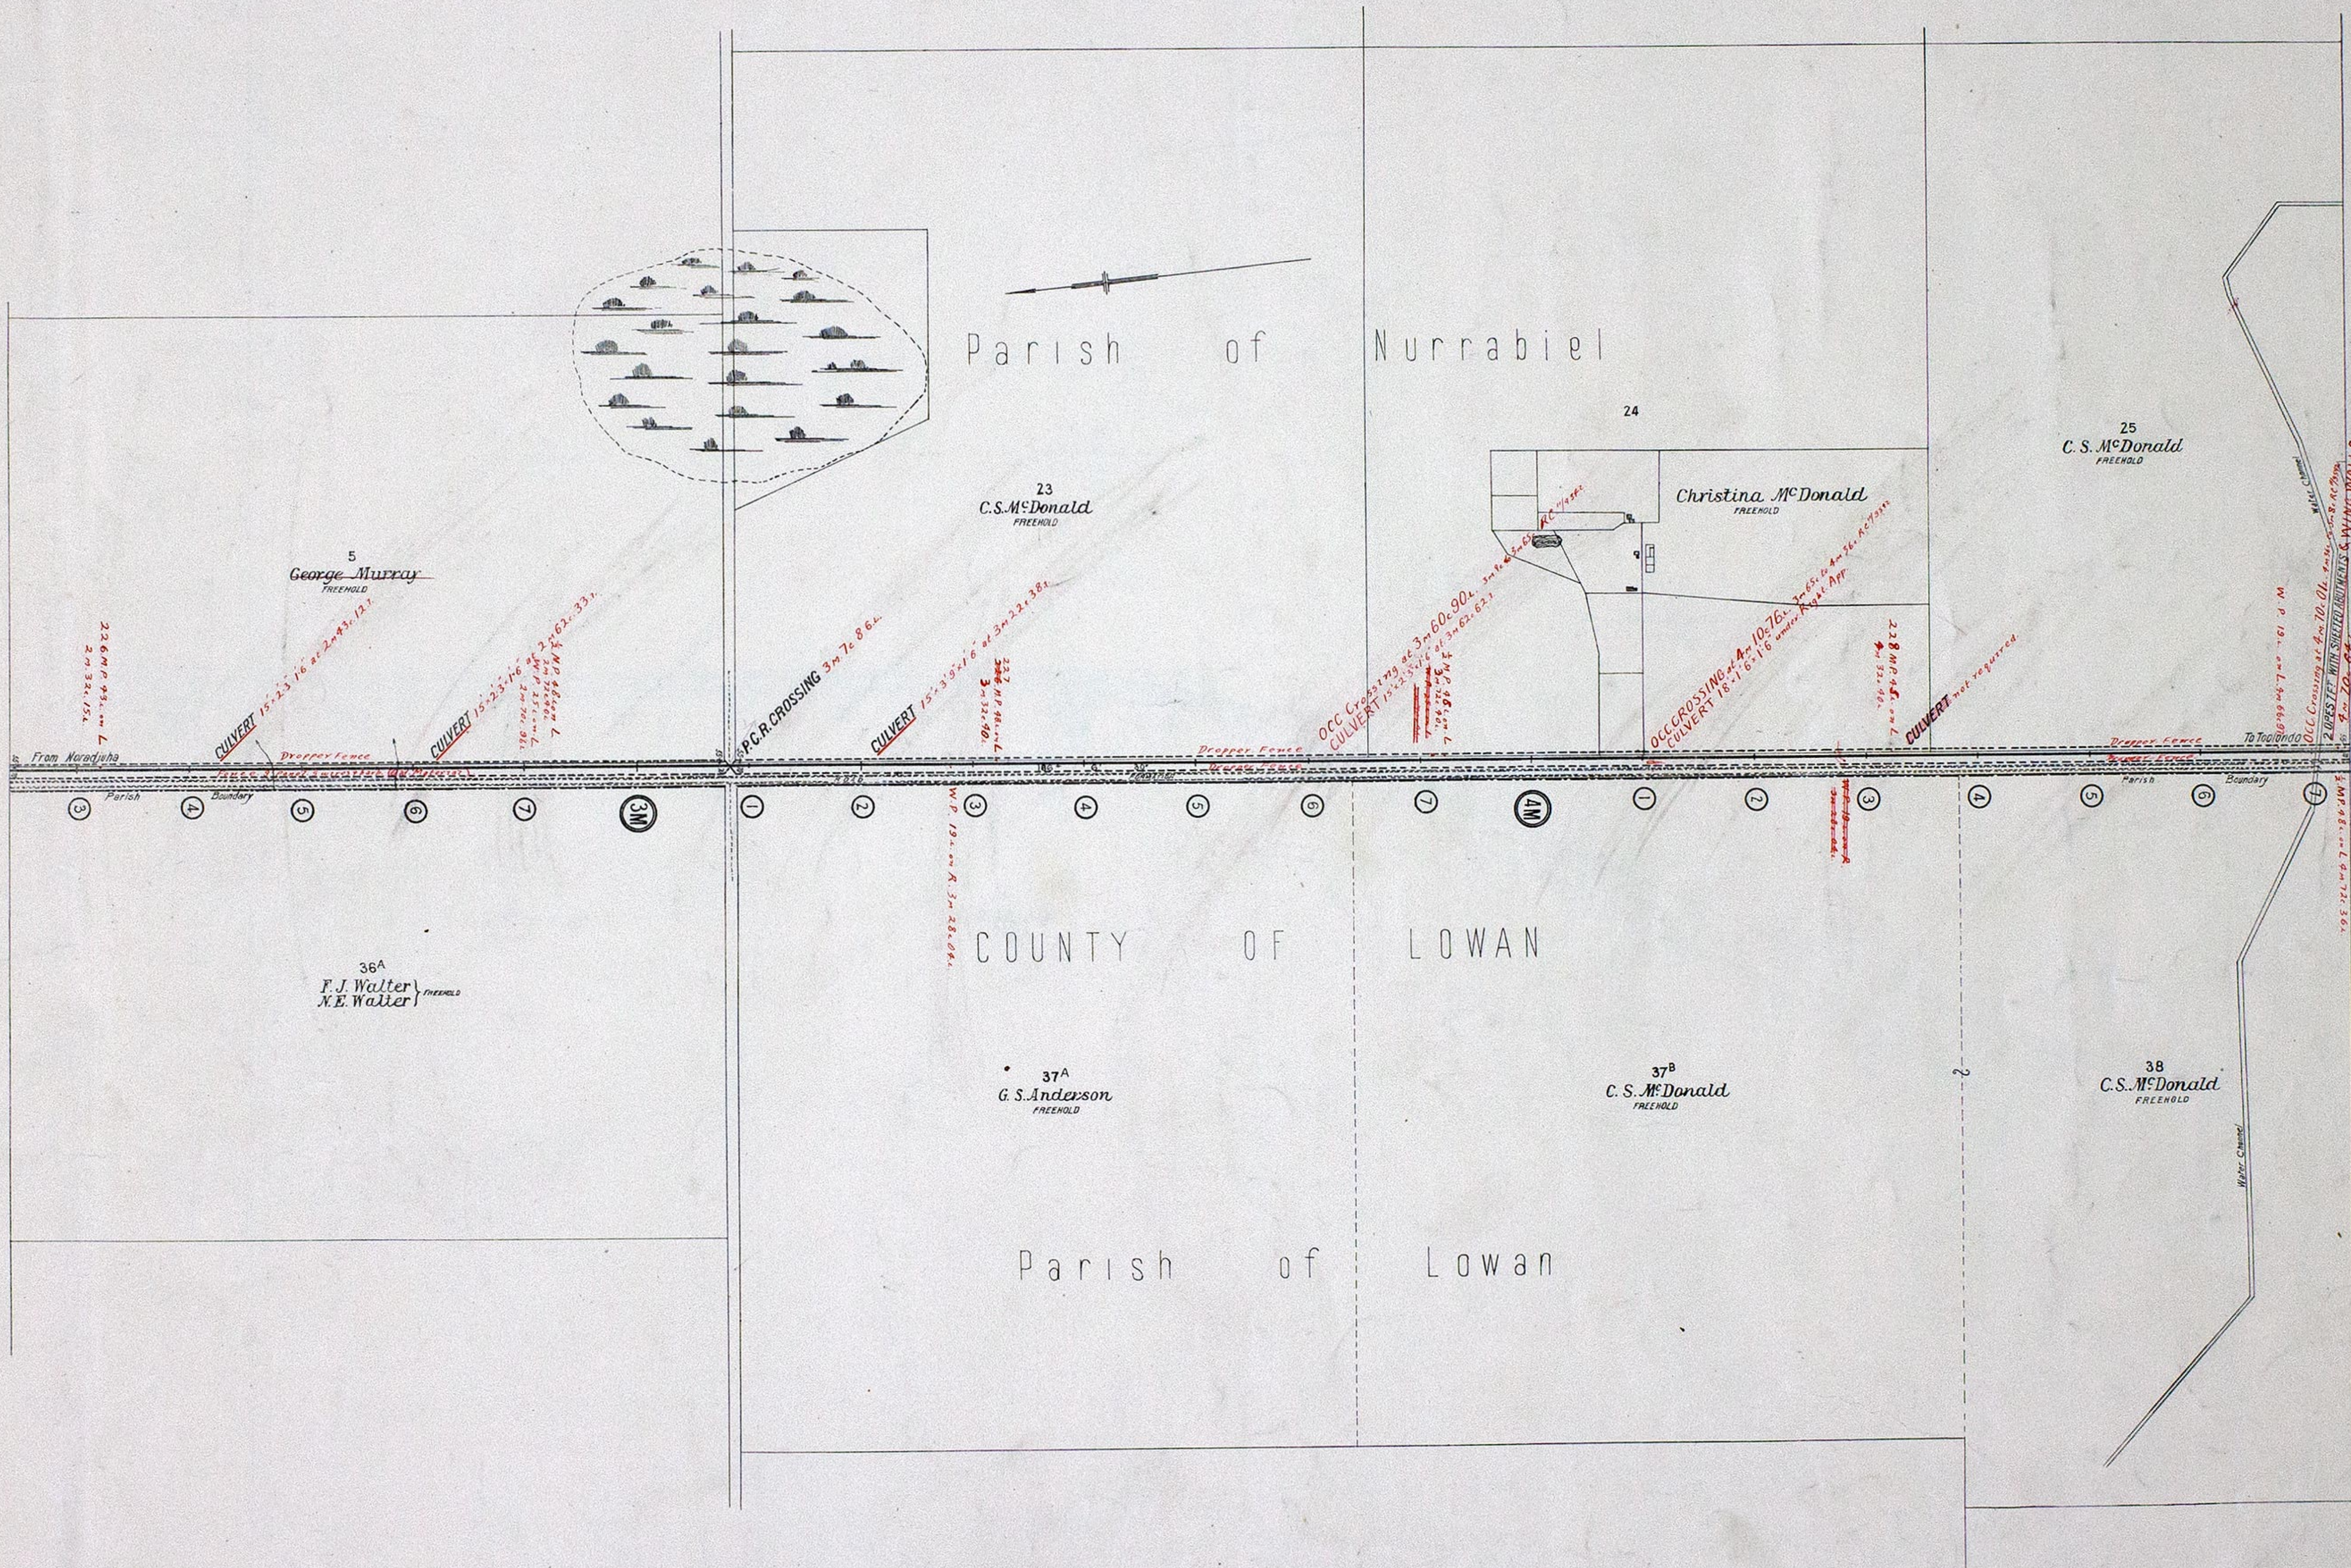

VICTORIAN RAILWAYS, NORADJUHA TO TOOLONDO

SCALE 10 CHAINS TO AN INCH


Nº 3

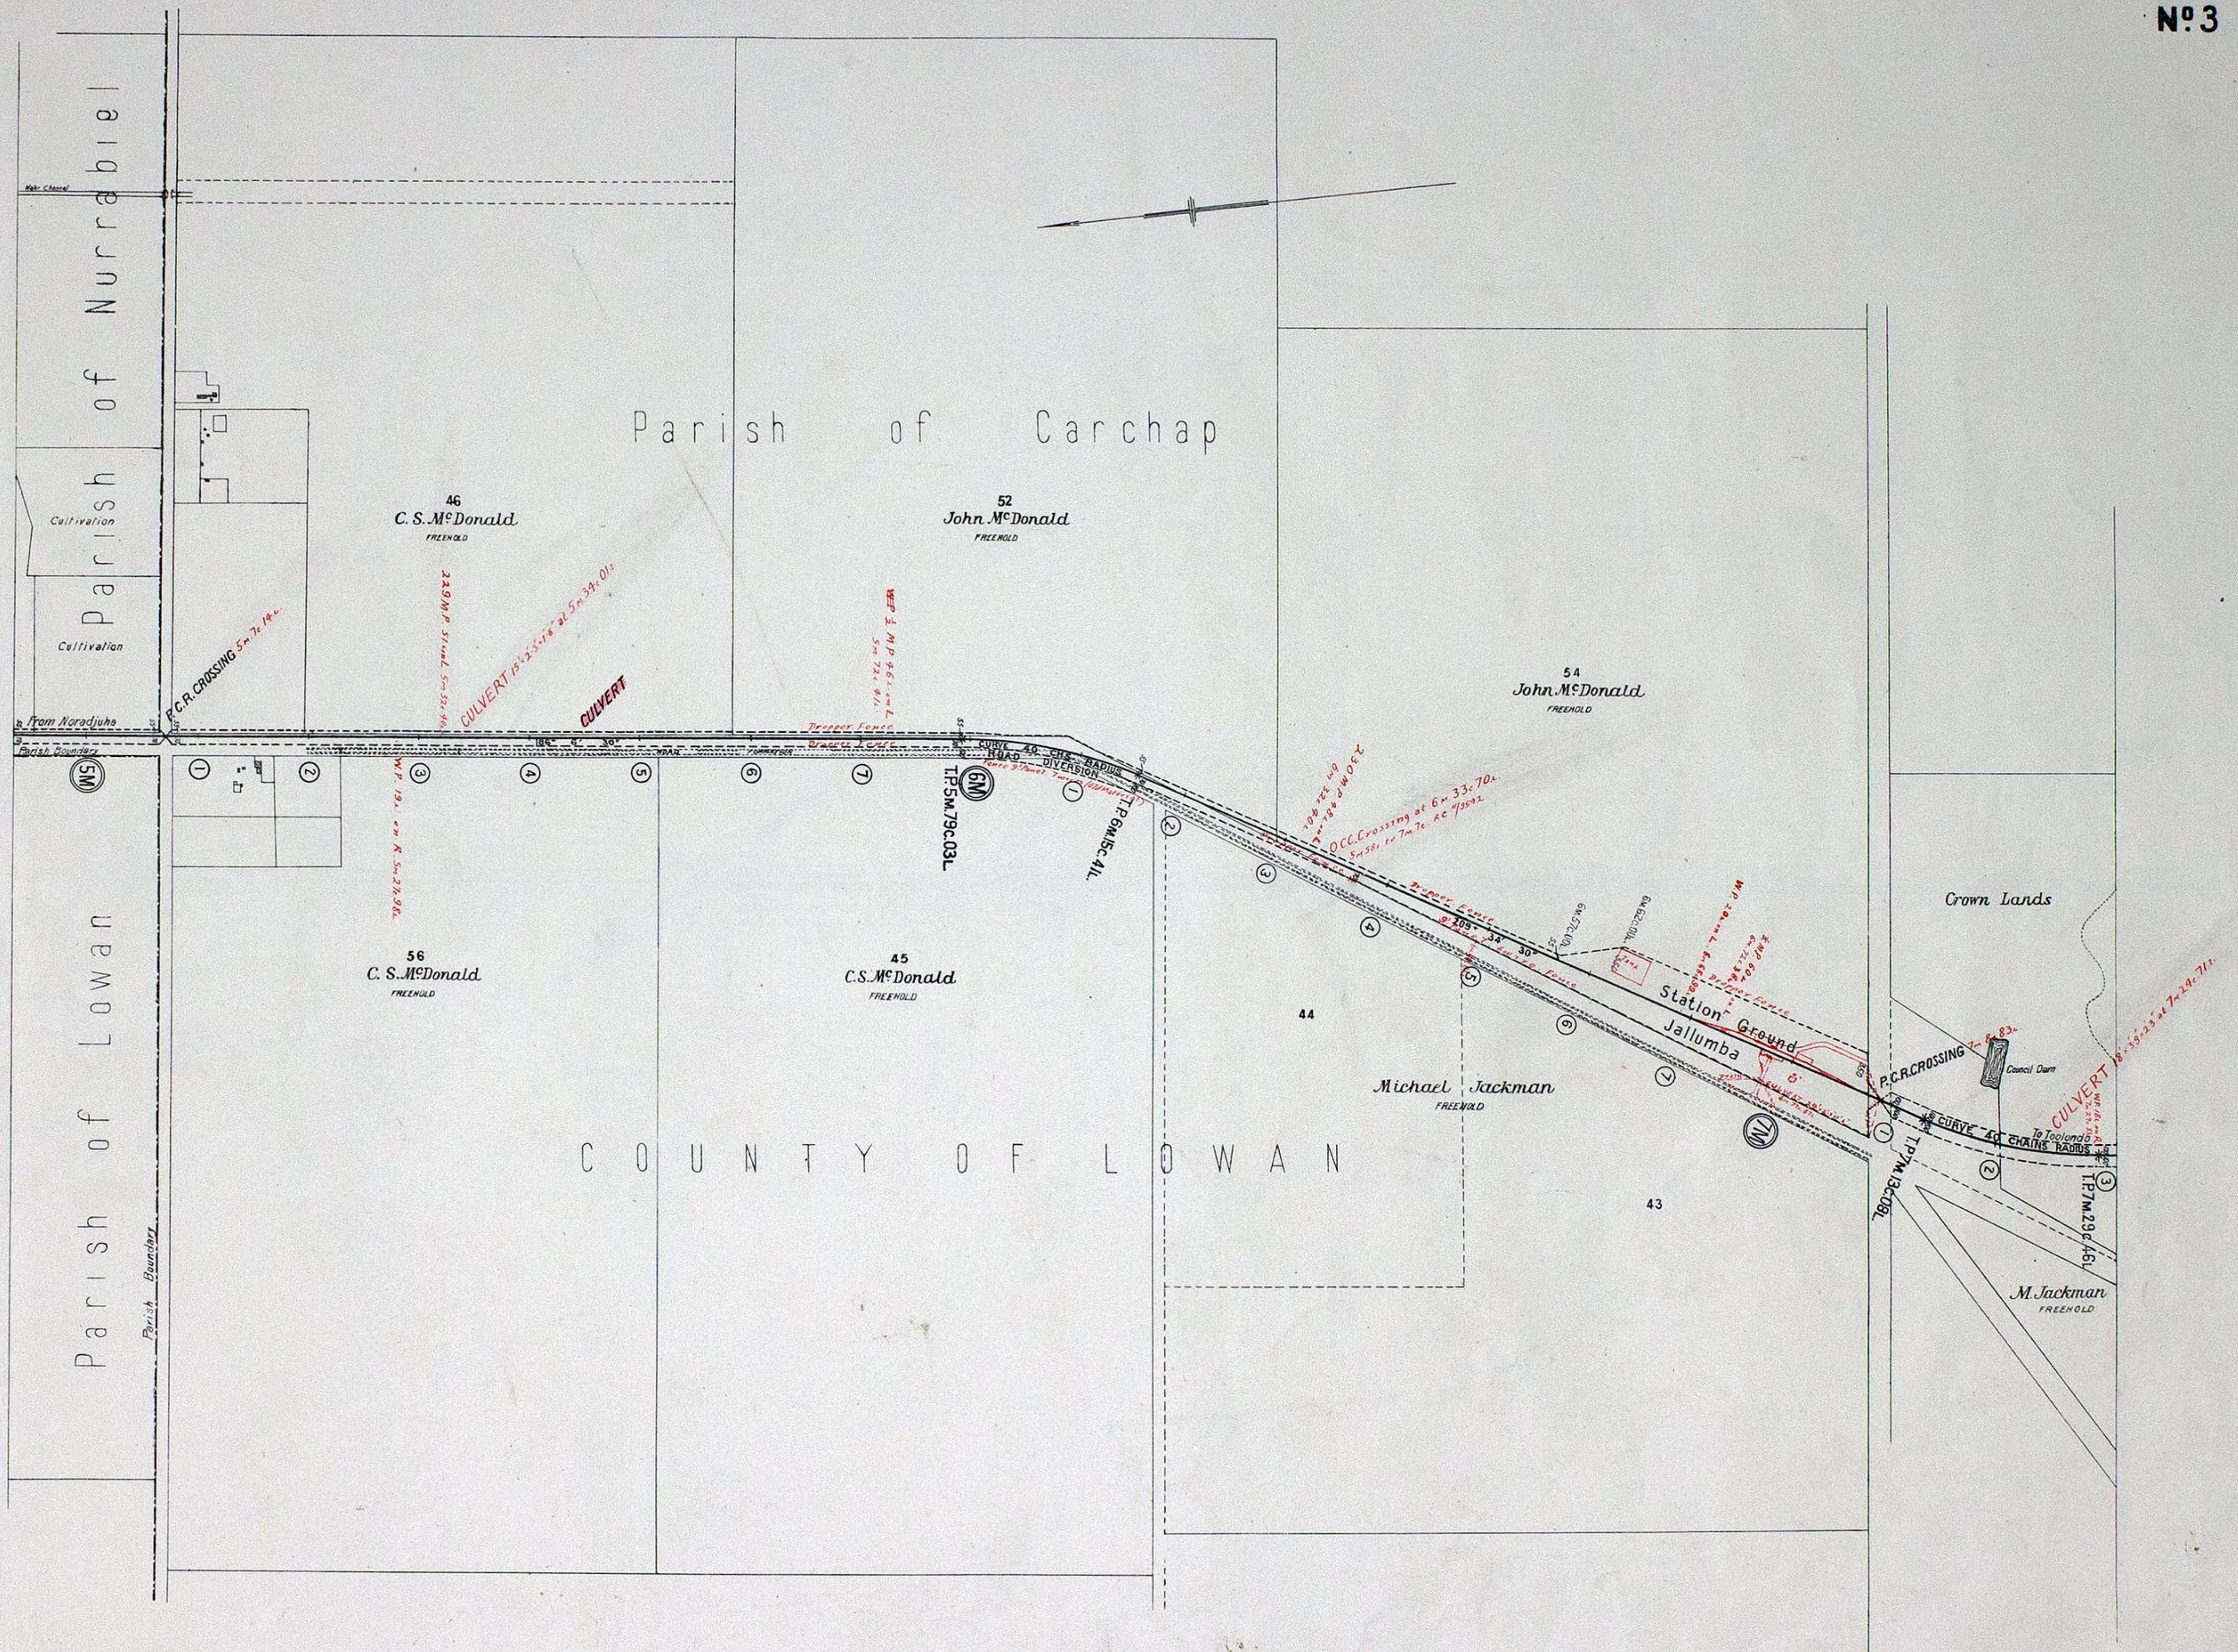

VICTORIAN RAILWAYS, NORADJUHA TO TCOLONDO

SCALE 10 CHAINS TO AN INCH


No 4

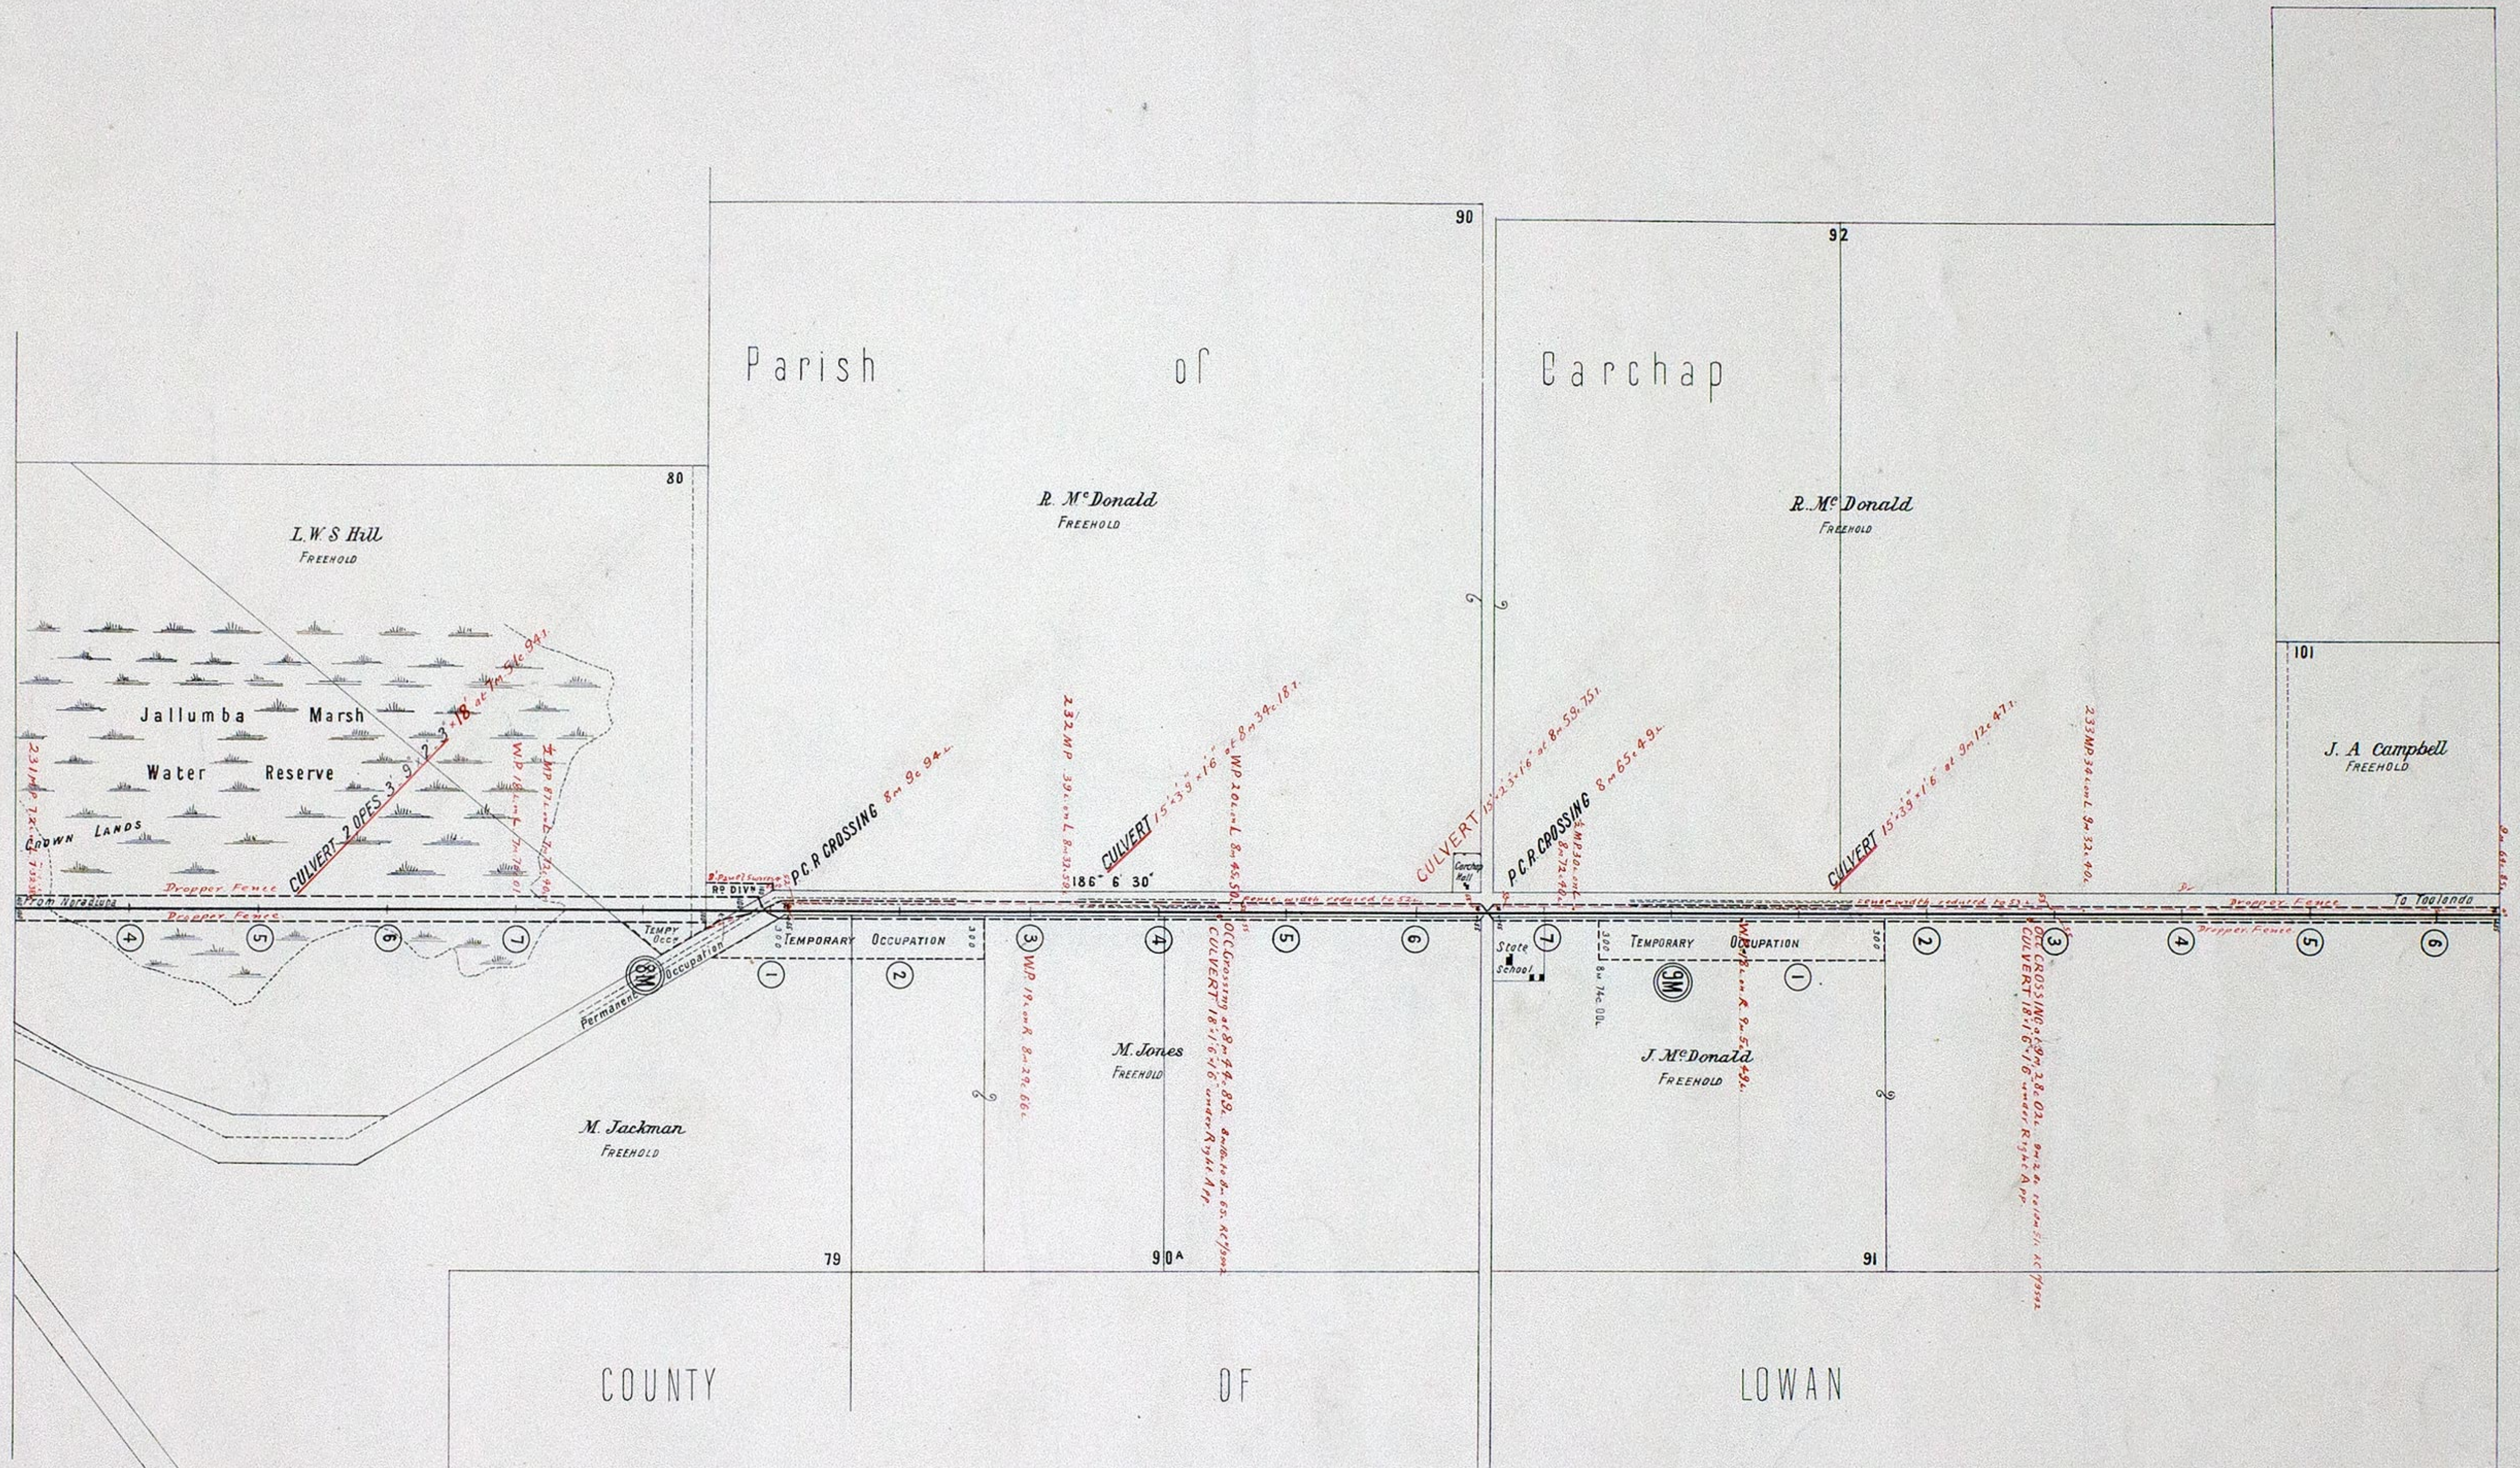

VICTORIAN RAILWAYS, NORADJUHA TO TOOLONDO

SCALE: 10 CHAINS TO AN INCH

No 5

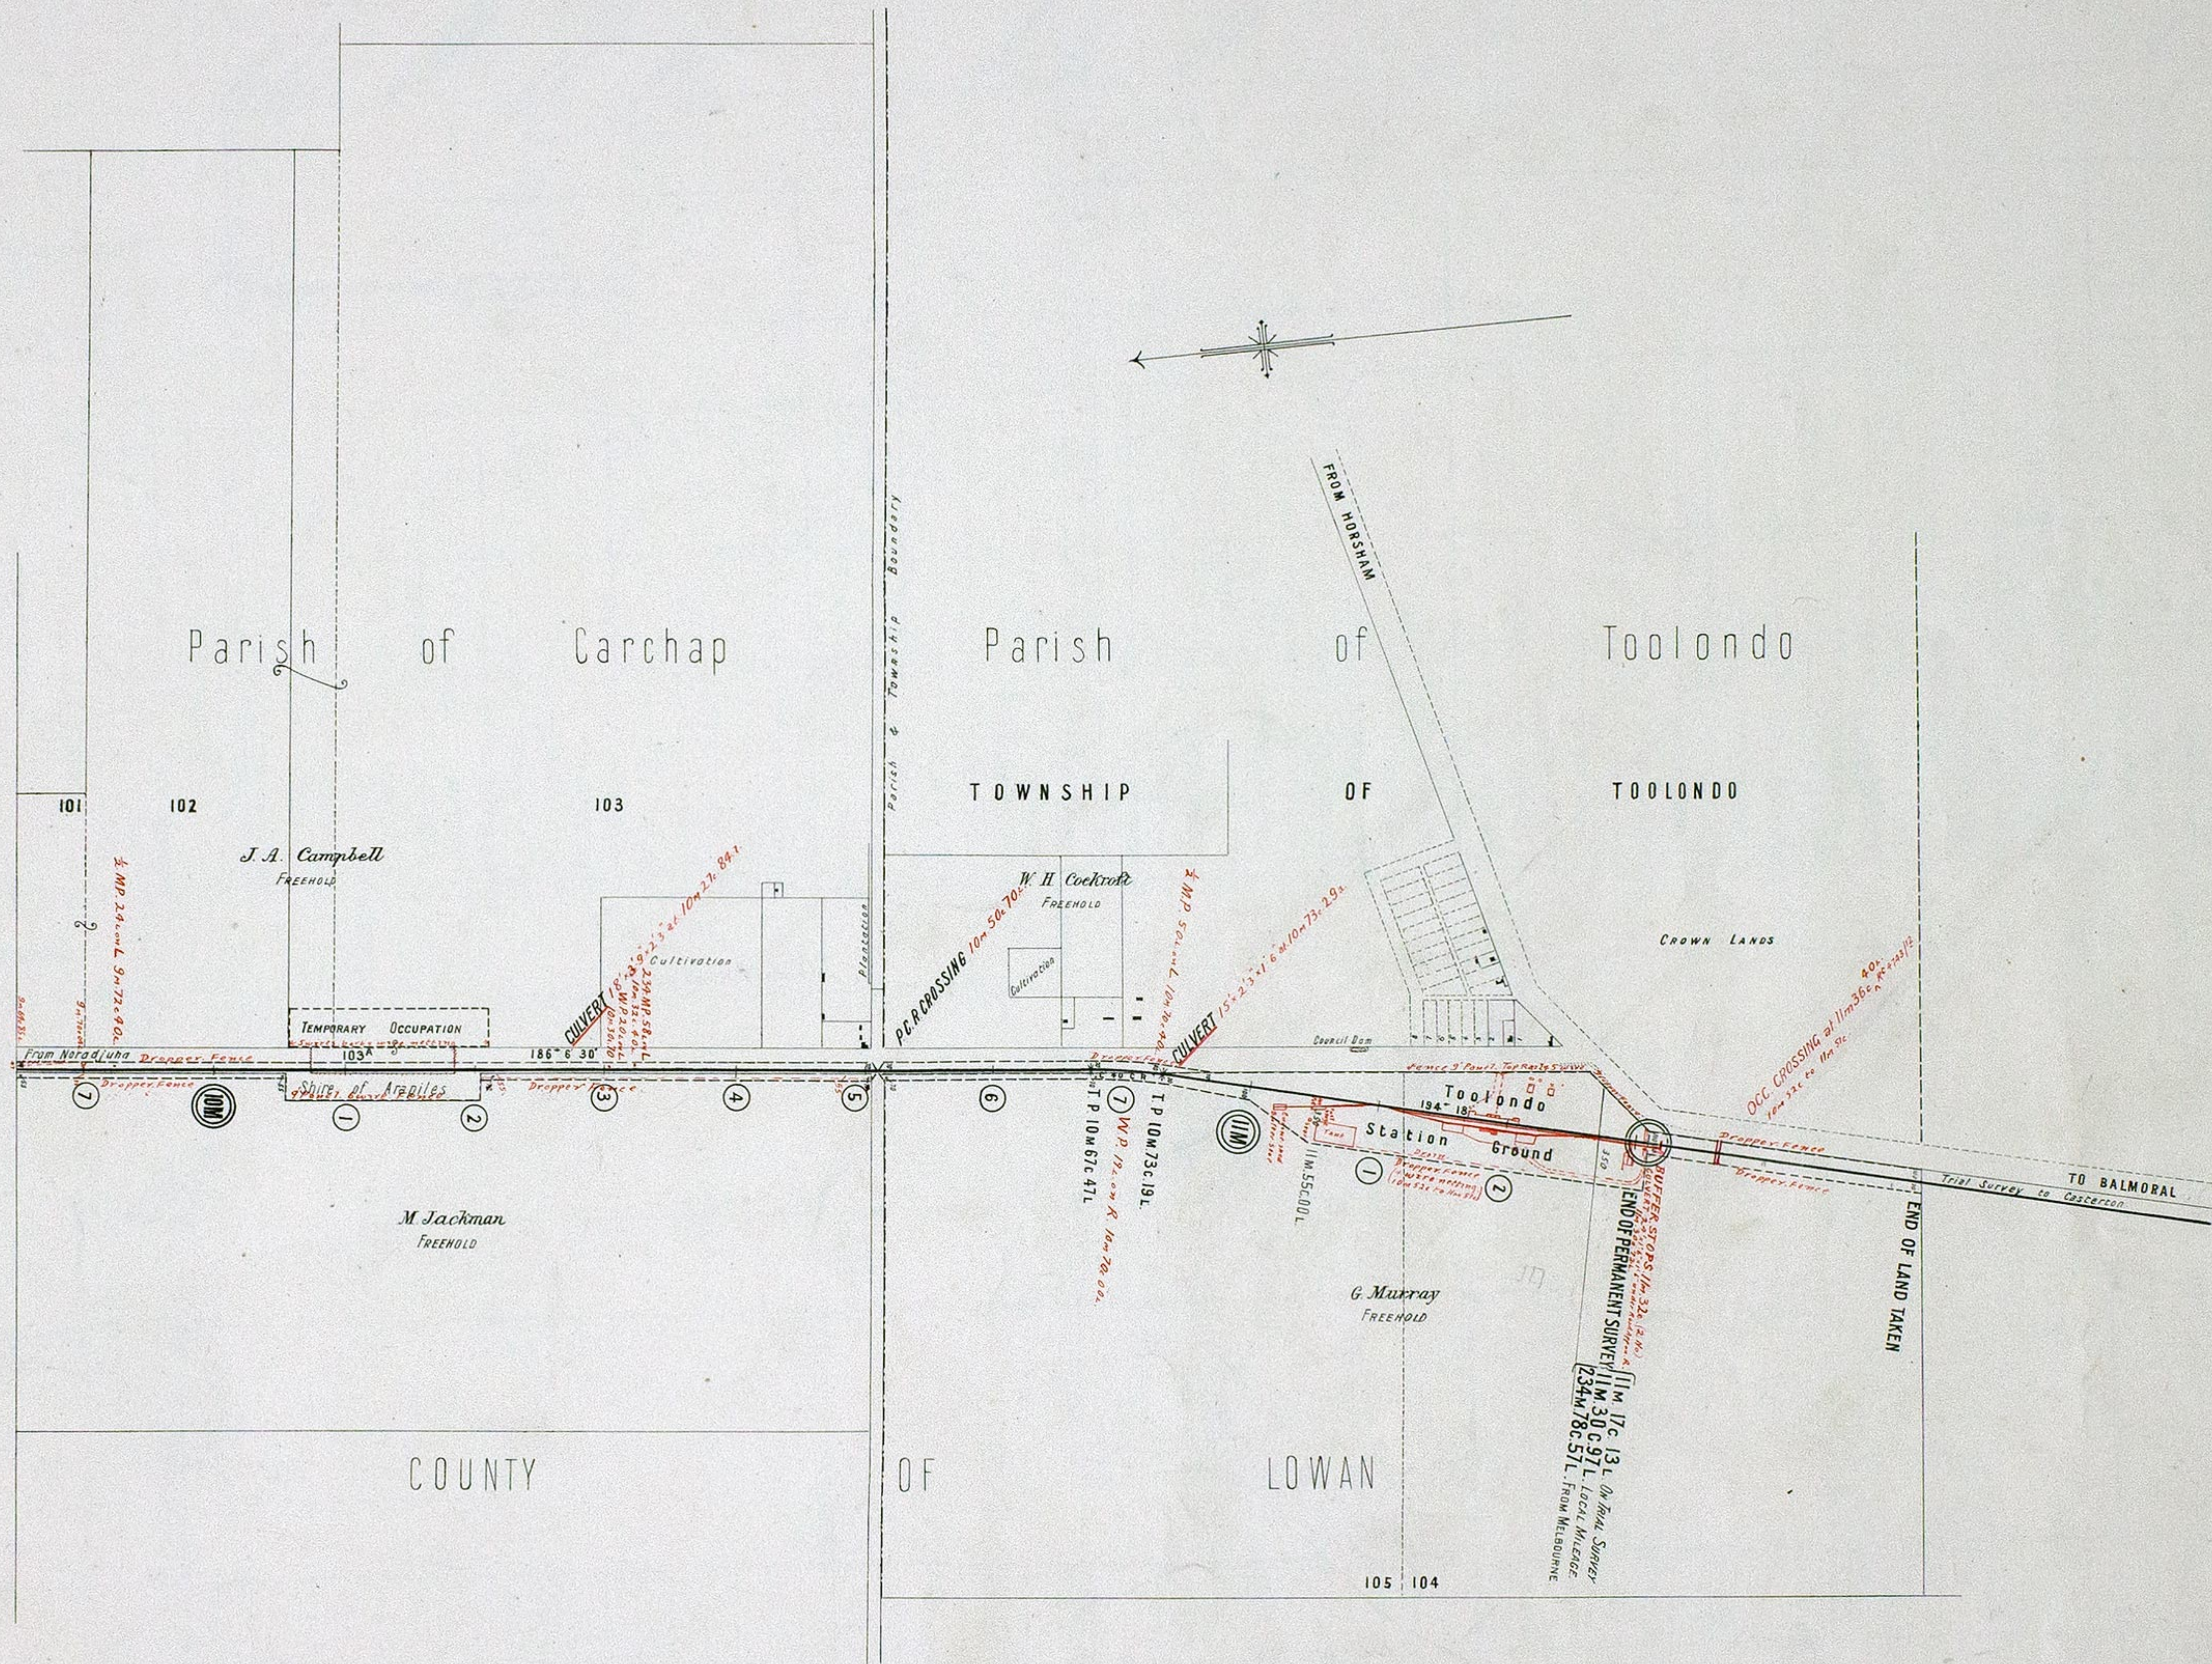

K.W. Holmes
24/10/10

VICTORIAN RAILWAYS, NORADJUHA TO TOOLONDO

No 1

SCALES { HORIZONTAL. 4 CHAINS TO AN INCH.
VERTICAL. 40 FEET TO AN INCH.

Centre of Platform { 223 M 47c 60L From Melbourne
19 M 64c 00L Local Mileage


End of Rails
Road Formation
P.C.R. CROSSING
CULVERT 15' x 23' 1/2' at 0+130.21
On 1/3c 85c

BM 471888 On Bullbank 821ks
Right of 0m 17c 45L

Force Townships Boundary
ROAD CLOSED
Yance


BM 471888 On Stump 851ks
Left of 0m 14c 4L

O.C.C. Crossing at 0+362.3
CULVERT 18' x 16' 1/2' under Left A.P.

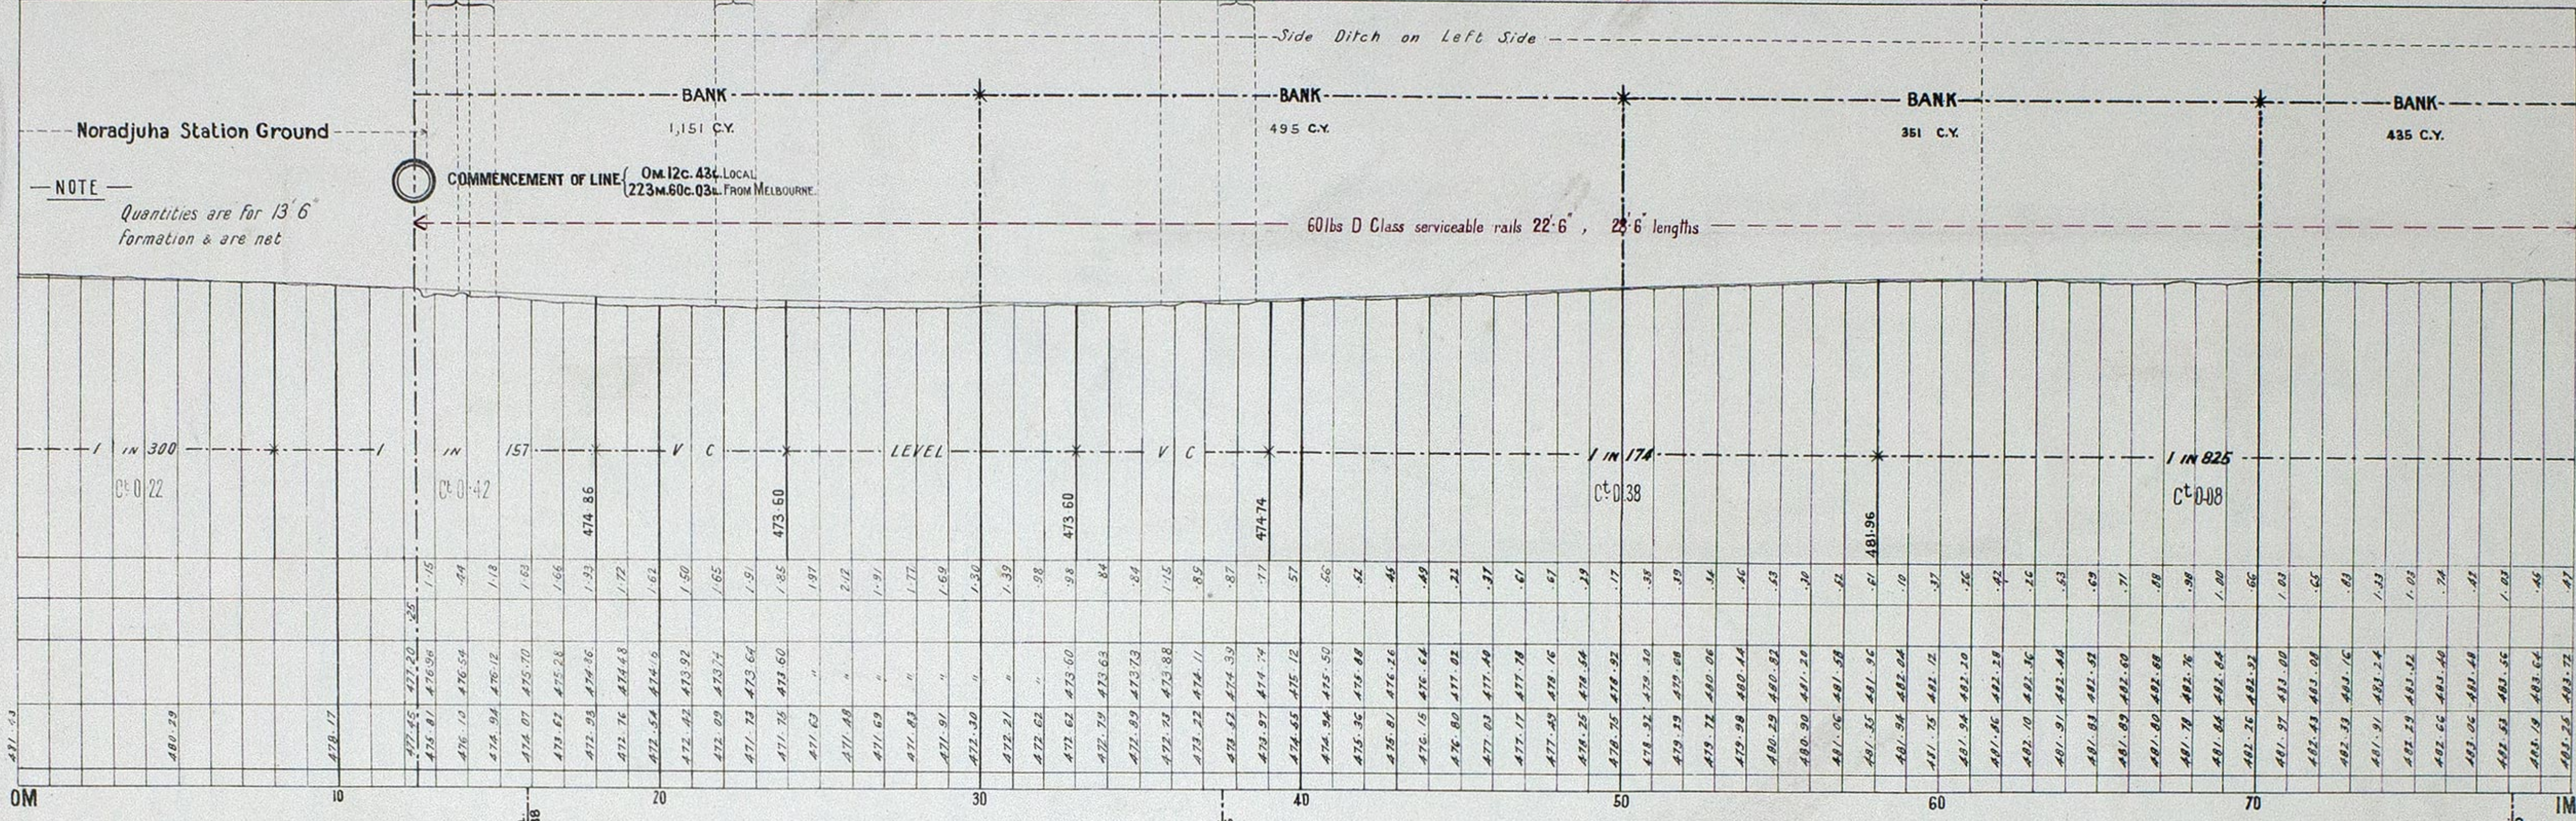

Bank
Cutting
Formation
Surface
Hobson's Bay
Datum 325 Feet above L.W.M.
Local Mileage
Through Mileage

OM 223 M 47c 60L FROM MELBOURNE
STRAIGHT 215° 42' 30"
CURVE 20 CHAINS RADIUS
M.C.L. 0 15 88
M.C.L. 0 31 56
T.P.
T.P.
T.P.
T.P.
IM 224 M 47c 60L FROM MELBOURNE
STRAIGHT 156° 20' 30"

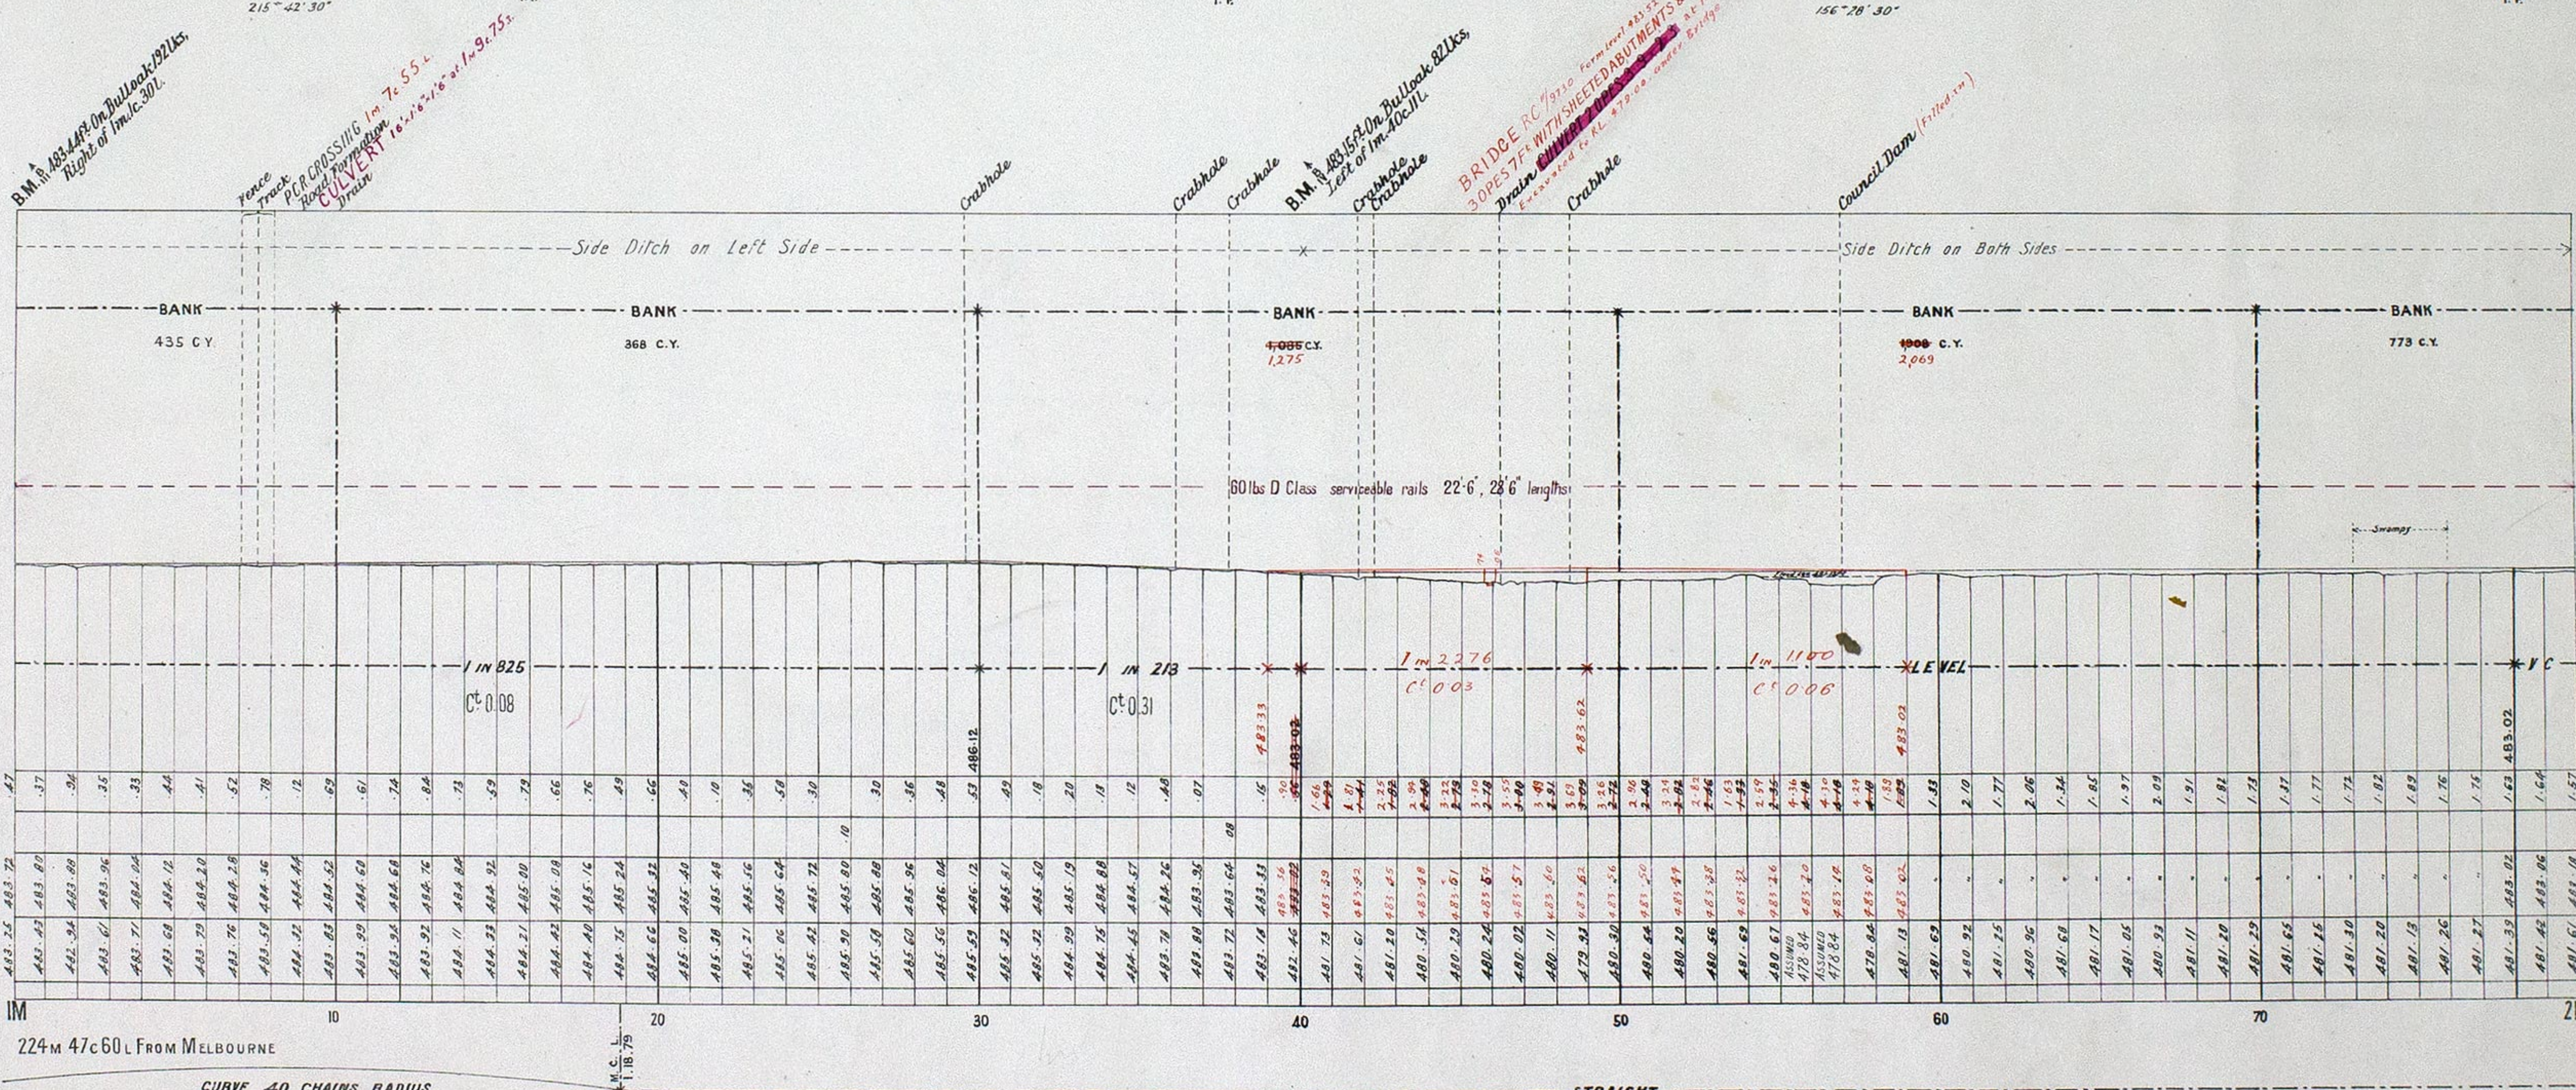



Bank
Cutting
Formation
Surface
Hobson's Bay
Datum 350 Feet above L.W.M.
Local Mileage
Through Mileage

1M 224 M 47c 60L FROM MELBOURNE
CURVE 40 CHAINS RADIUS
M.C.L. 1 18 79
M.C.L. 1 34 10
T.P.
T.P.
T.P.
T.P.
2M
STRAIGHT 186° 6' 30"

VICTORIAN RAILWAYS, NORADJUHA TO TOOLONDO

No 2

SCALES { HORIZONTAL, 4 CHAINS TO AN INCH.
VERTICAL, 40 FEET TO AN INCH.

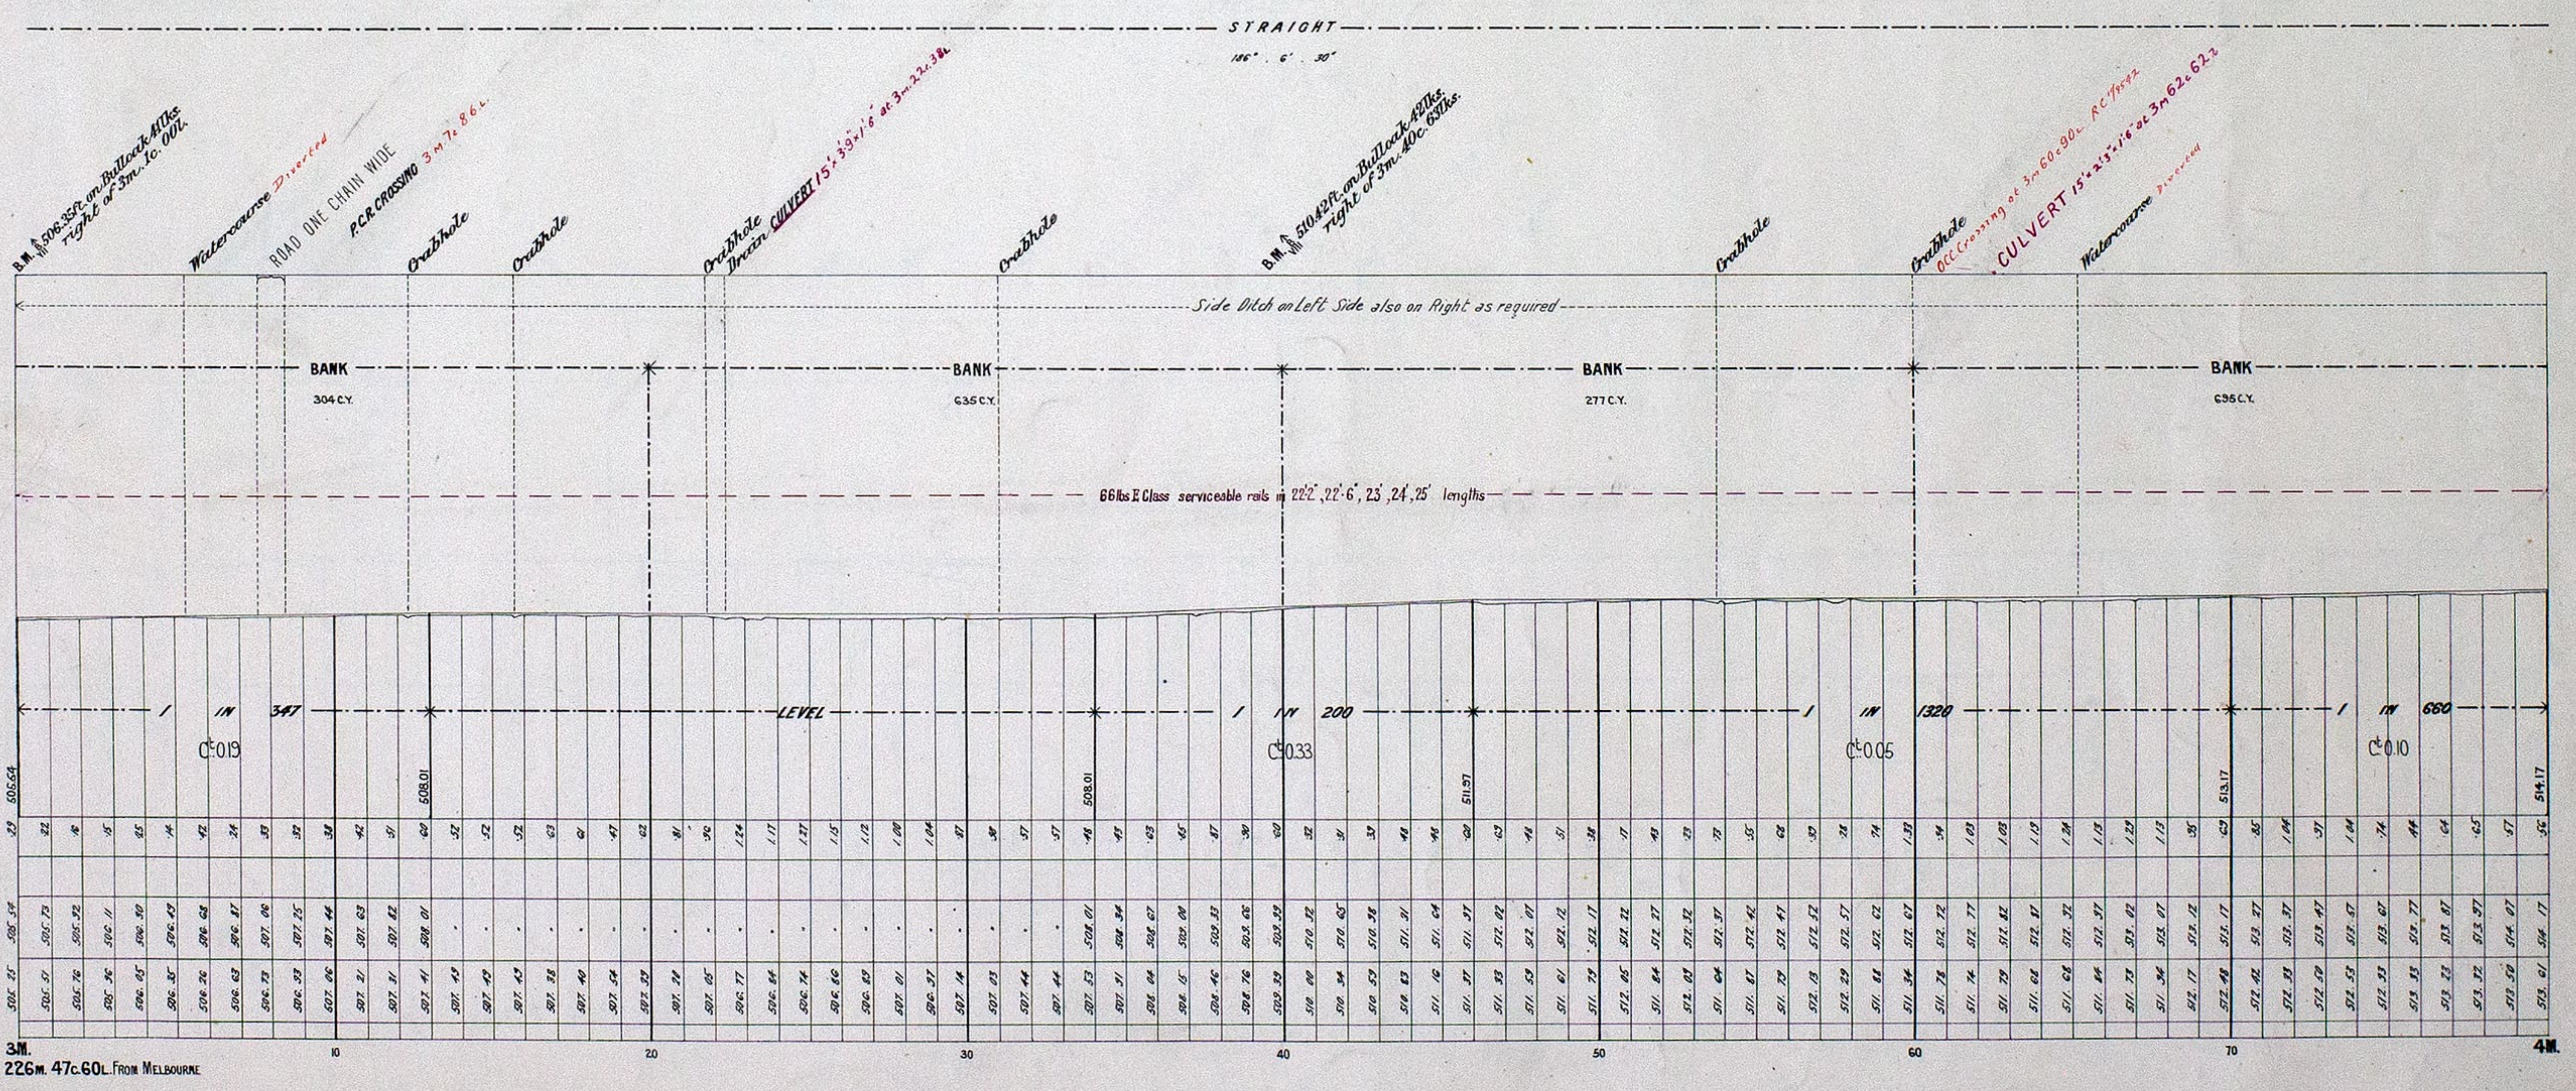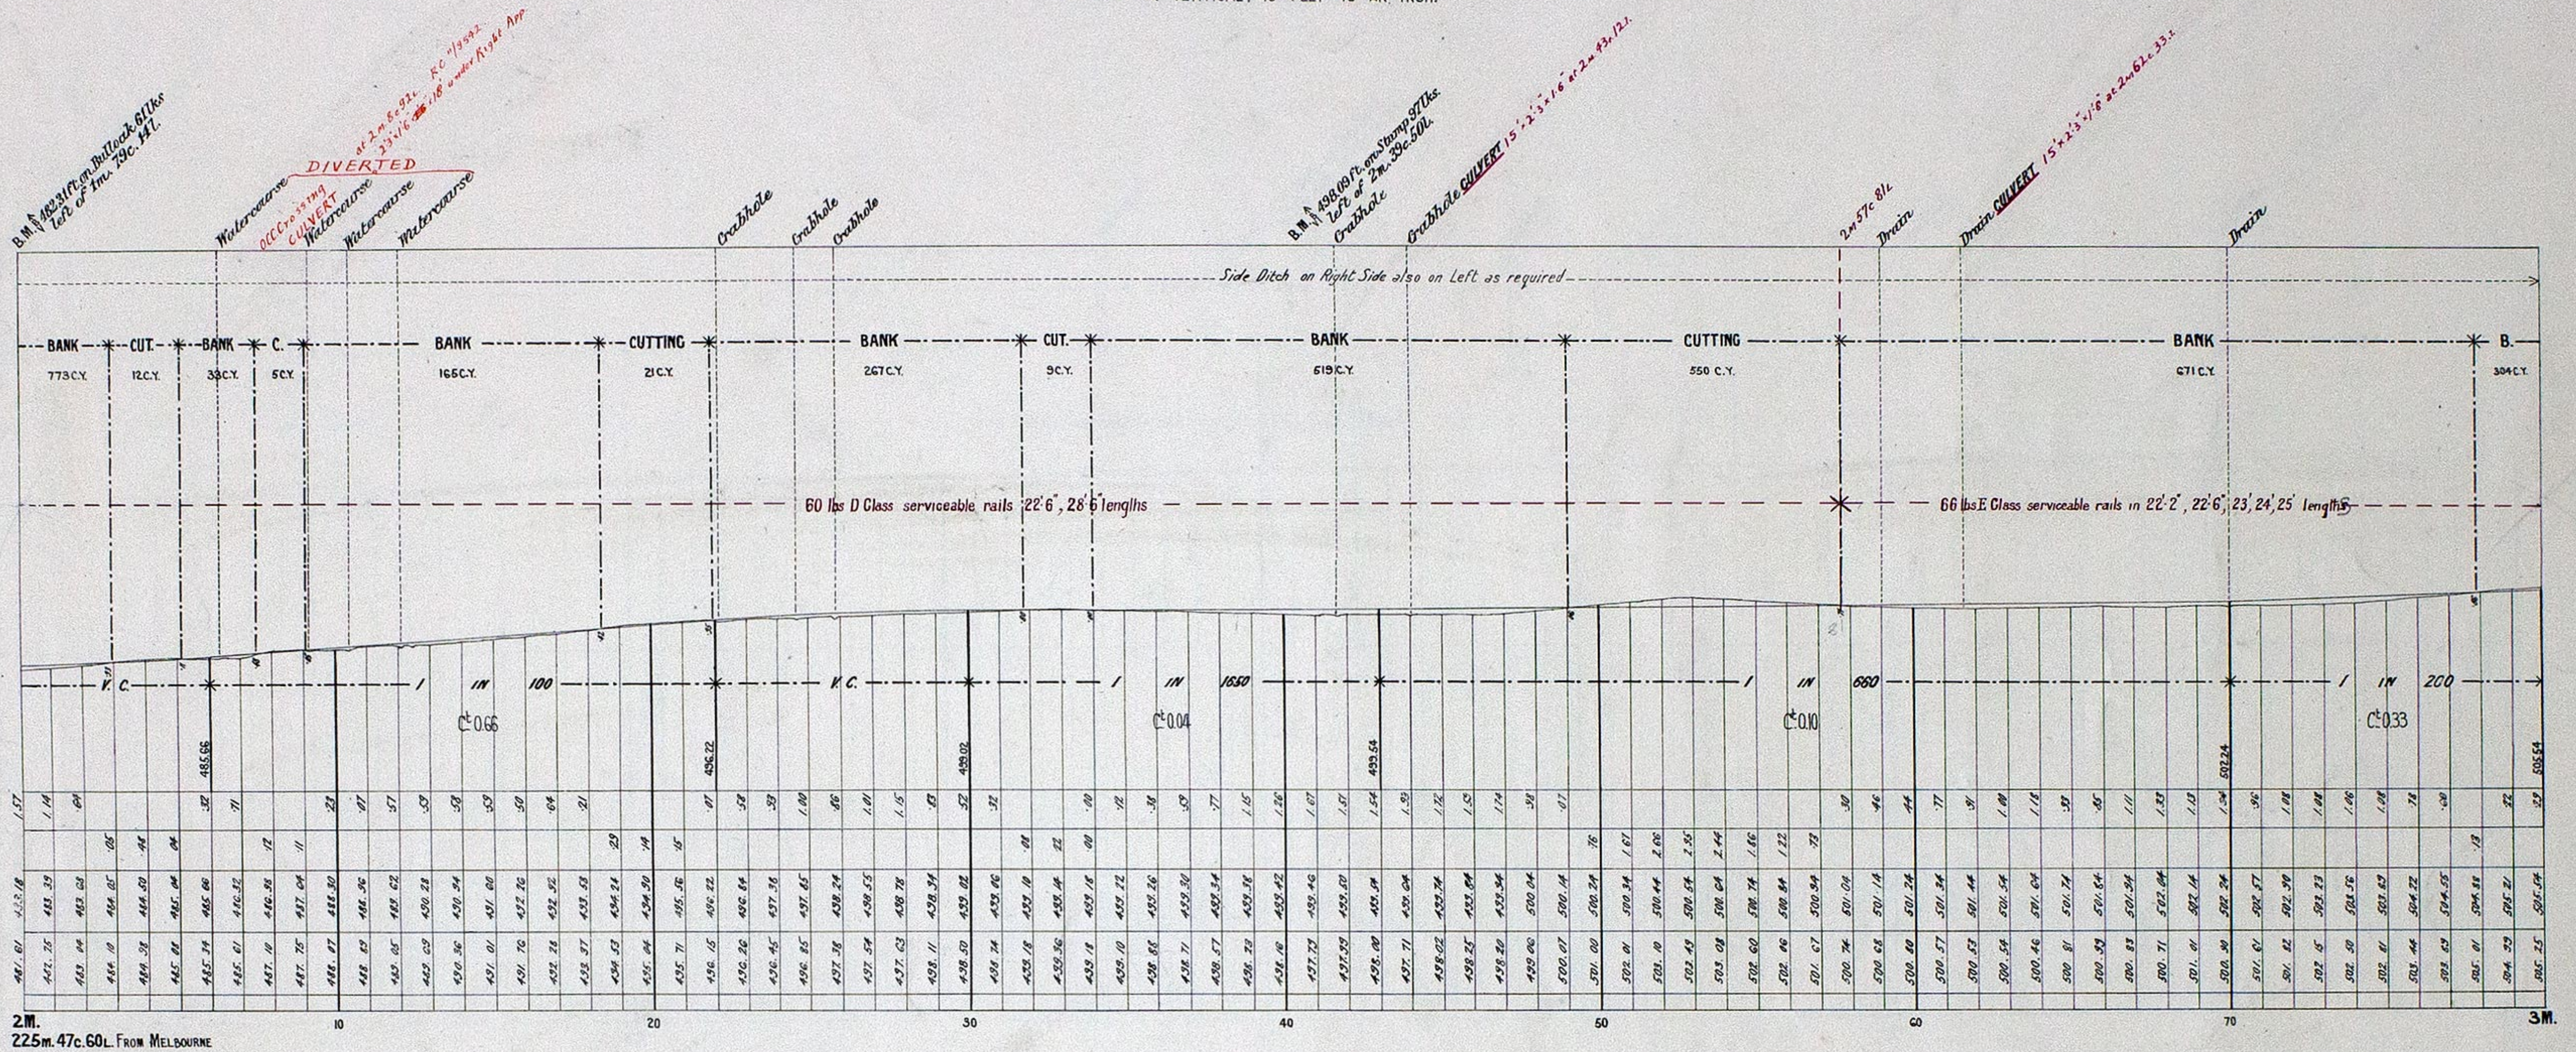



Bank
Cutting
Formation
Surface
Hobson's Bay
Datum 375 Feet above L.W.M.
Local Mileage
Through Mileage

Bank
Cutting
Formation
Surface
Hobson's Bay
Datum 375 Feet above L.W.M.
Local Mileage
Through Mileage

VICTORIAN RAILWAYS, NORADJUHA TO TOOLONDO

SCALES { HORIZONTAL. 4 CHAINS TO AN INCH.
VERTICAL. 40 FEET TO AN INCH.

No 3

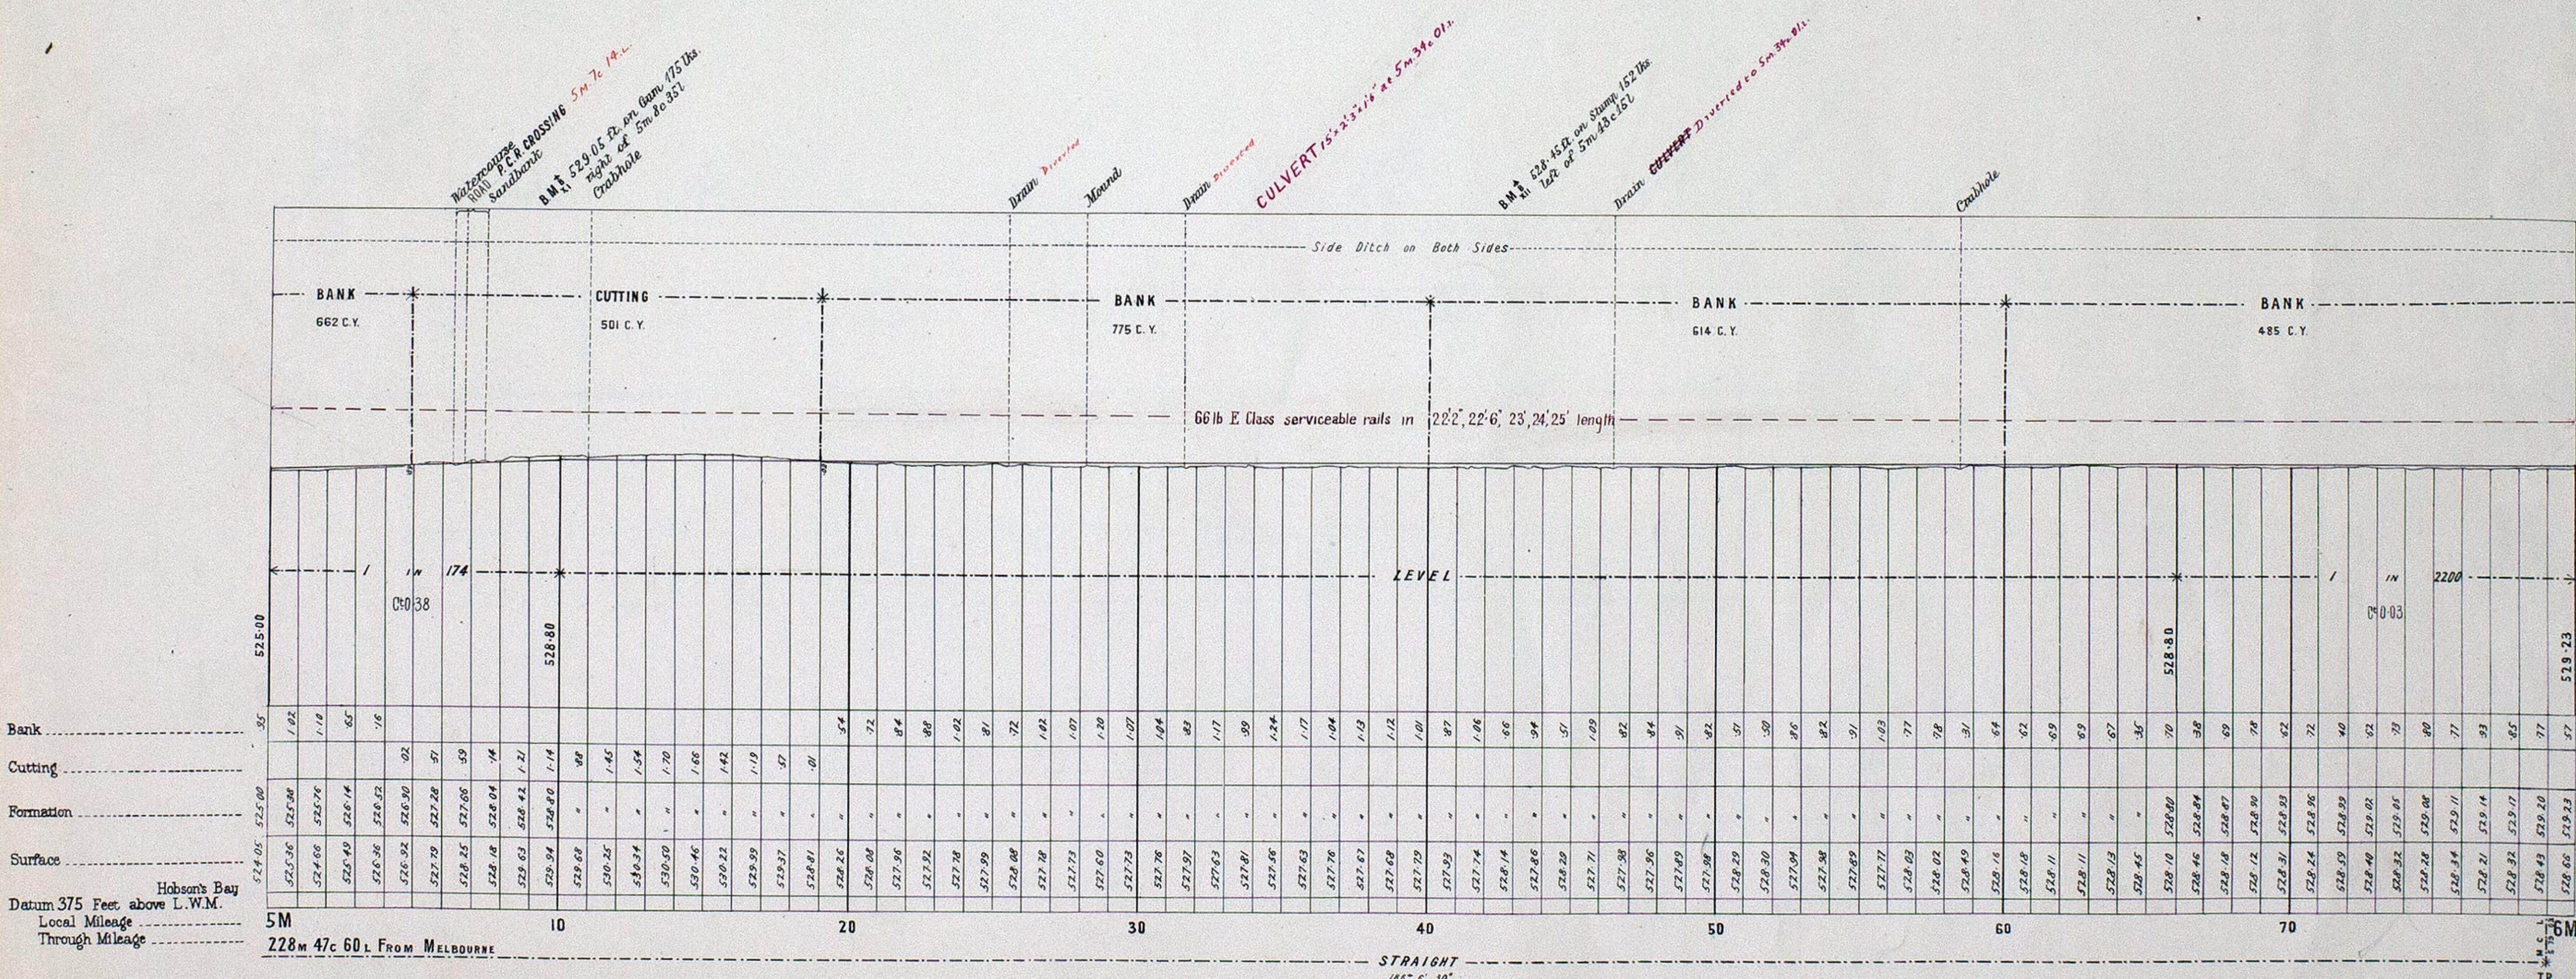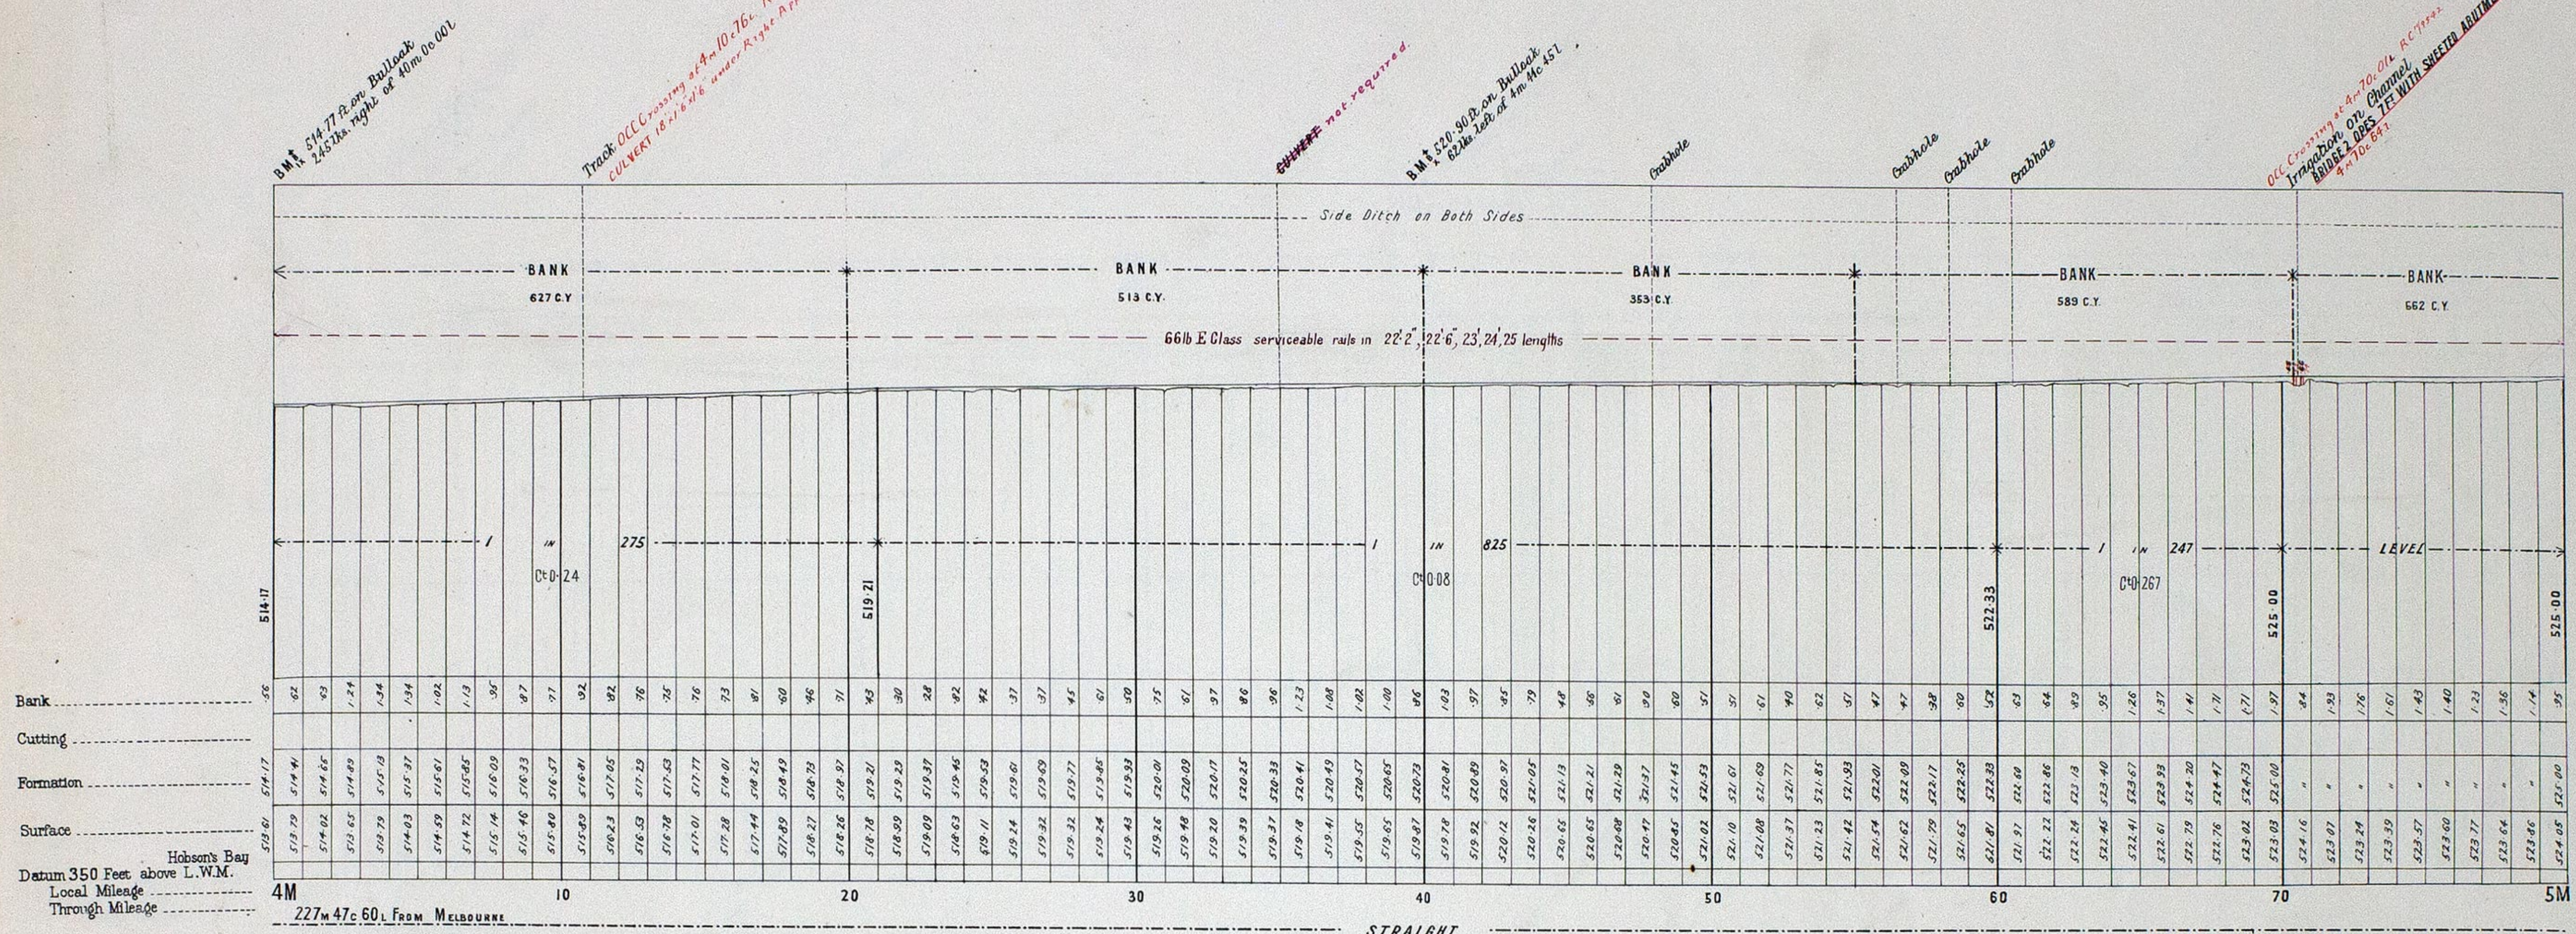

VICTORIAN RAILWAYS, NORADJUHA TO TOOLONDO

Nº 4

SCALES { HORIZONTAL. 4 CHAINS TO AN INCH.
VERTICAL. 40 FEET TO AN INCH.

